





FOR APPROVAL ONLY

PRINT NAME: _____


SIGNATURE: _____

DATE: _____

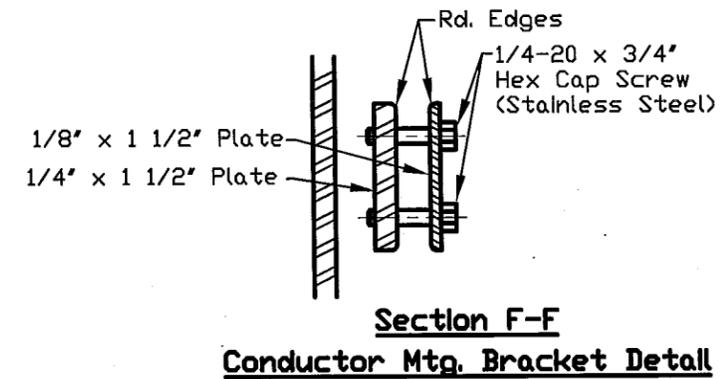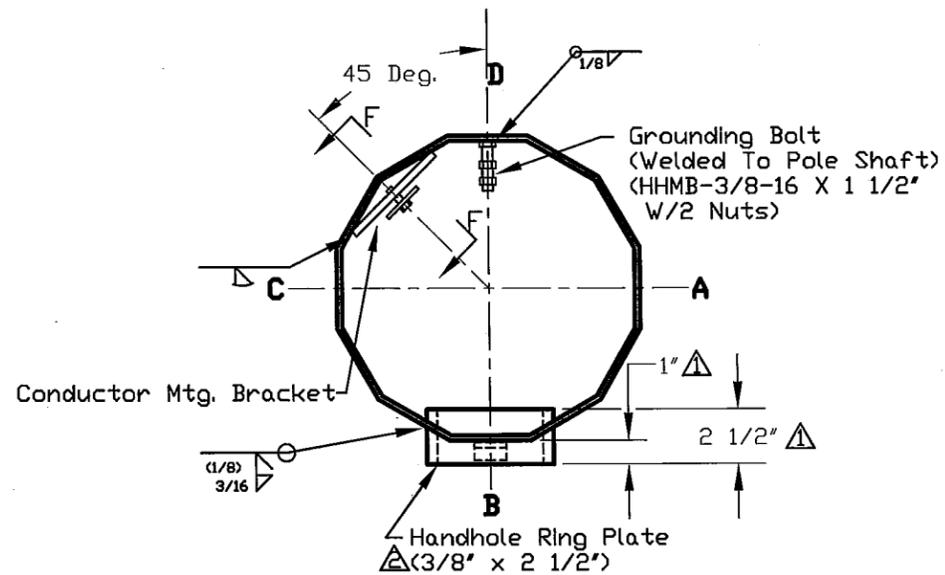


APPROVED

Manufacturer's Pole Plan
 Approved For Listing As A
 Pre-Approved Drawing
 WSDOT Bridge & Structures Office
 By GB Date 11-9-09

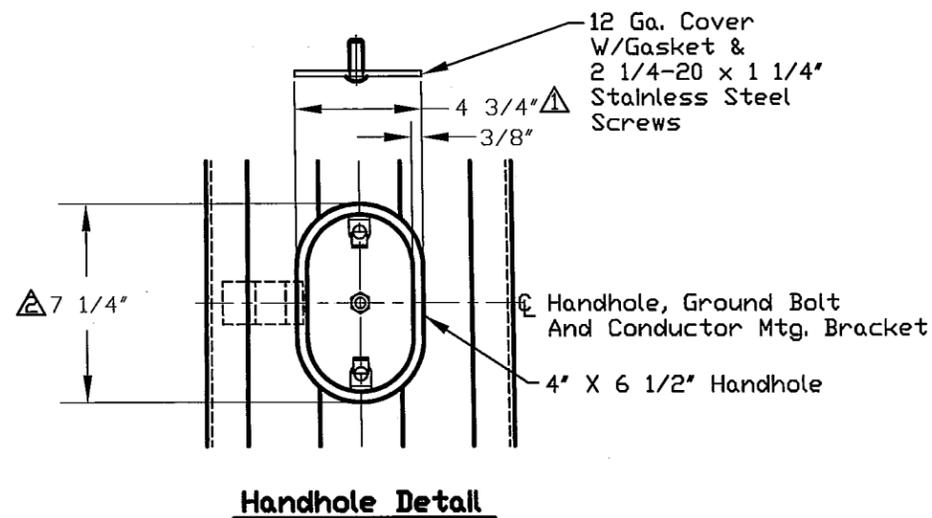

4	CHANGED REVISION NUMBER TO MATCH REVISION NUMBER ON SHT 1 OF 3 PER WASHINGTON D.O.T. REQUEST.	JHG	11/5/2009
2	REVISED PER RETURNED MARKED-UP DRAWING.	JHG	10/19/2009
1	REVISED PER RETURNED MARKED-UP DRAWING.	JHG	9/18/2009
REV.	DESCRIPTION	BY	DATE

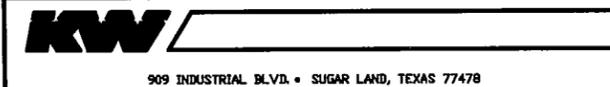

STATE OF WASHINGTON
 'J' TYPE ROADWAY POLE

SHT. 3 OF 3

DRAWN BY:	JHG	DATE:	9/27/2007	DRAWING NO.:	10-31-RWP-1	REV.:	4
APPROVED BY:		DATE:					