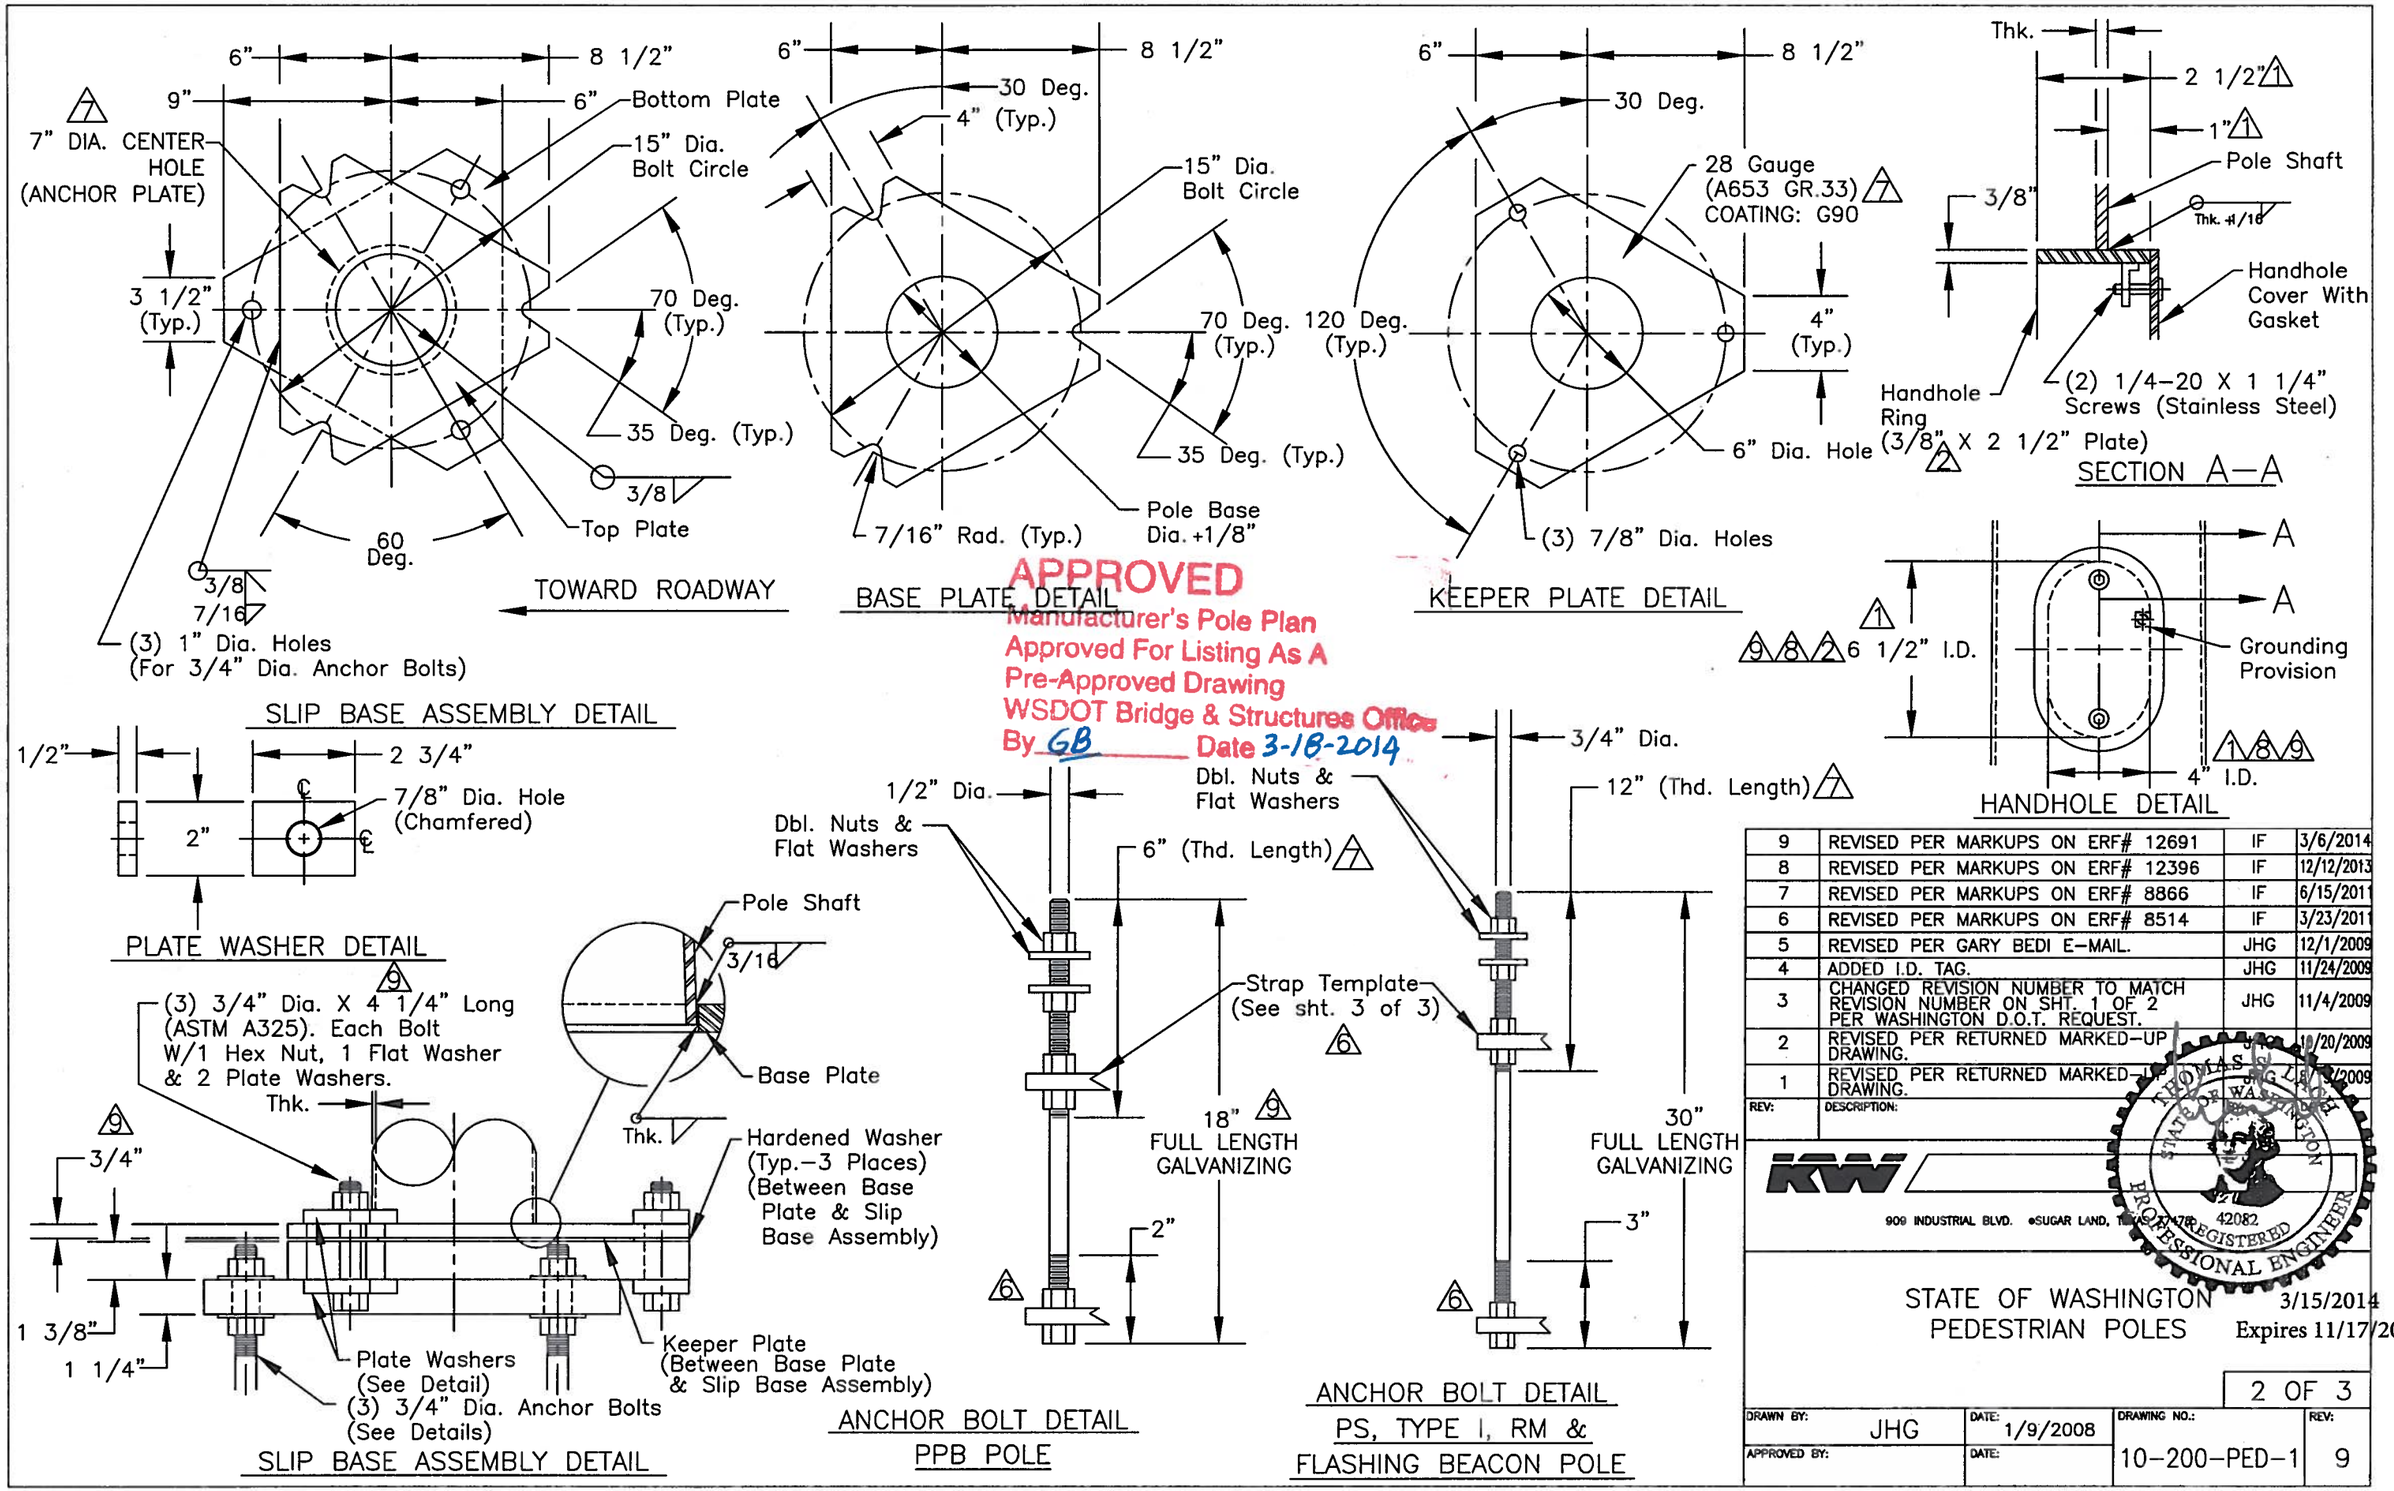

APPROVED
Manufacturer's Pole Plan
Approved For Listing As A
Pre-Approved Drawing
WSDOT Bridge & Structures Office
By GB Date 3-18-2014

REV:	DESCRIPTION:		
9	REVISED PER MARKUPS ON ERF# 12691	IF	3/6/2014
8	REVISED PER MARKUPS ON ERF# 12396	IF	12/12/2013
7	REVISED PER MARKUPS ON ERF# 8866	IF	6/15/2011
6	REVISED PER MARKUPS ON ERF# 8514	IF	3/23/2011
5	REVISED PER GARY BEDI E-MAIL.	JHG	12/1/2009
4	ADDED I.D. TAG.	JHG	11/24/2009
3	CHANGED REVISION NUMBER TO MATCH REVISION NUMBER ON SHT. 1 OF 2 PER WASHINGTON D.O.T. REQUEST.	JHG	11/4/2009
2	REVISED PER RETURNED MARKED-UP DRAWING.	JHG	10/20/2009
1	REVISED PER RETURNED MARKED-UP DRAWING.	JHG	[illegible]/2009

KW
909 INDUSTRIAL BLVD. •SUGAR LAND, TEXAS 77478

THOMAS J. LACH
STATE OF WASHINGTON
42082
REGISTERED PROFESSIONAL ENGINEER
3/15/2014
Expires 11/17/2014

STATE OF WASHINGTON
PEDESTRIAN POLES

2 OF 3

DRAWN BY: JHG	DATE: 1/9/2008	DRAWING NO.: 10-200-PED-1	REV: 9
APPROVED BY:	DATE:		