Designing Engineer	O.R. Dinsmore Oct 1949
Designed	P.C.Y. Sept. 1949
Design Checked	C.C.Y. Oct. 1949
Quantities By	P.C.Y. Sept. 1949
Quantities Figured	
Quantities Checked	

FED. ROAD DIST. NO.	STATE	FED. AID PROJ. NO.	FISCAL YEAR	SHEET NO.	TOTAL SHEETS
8	WASH.				

Note:
Profile grade shown is Finished Grade.

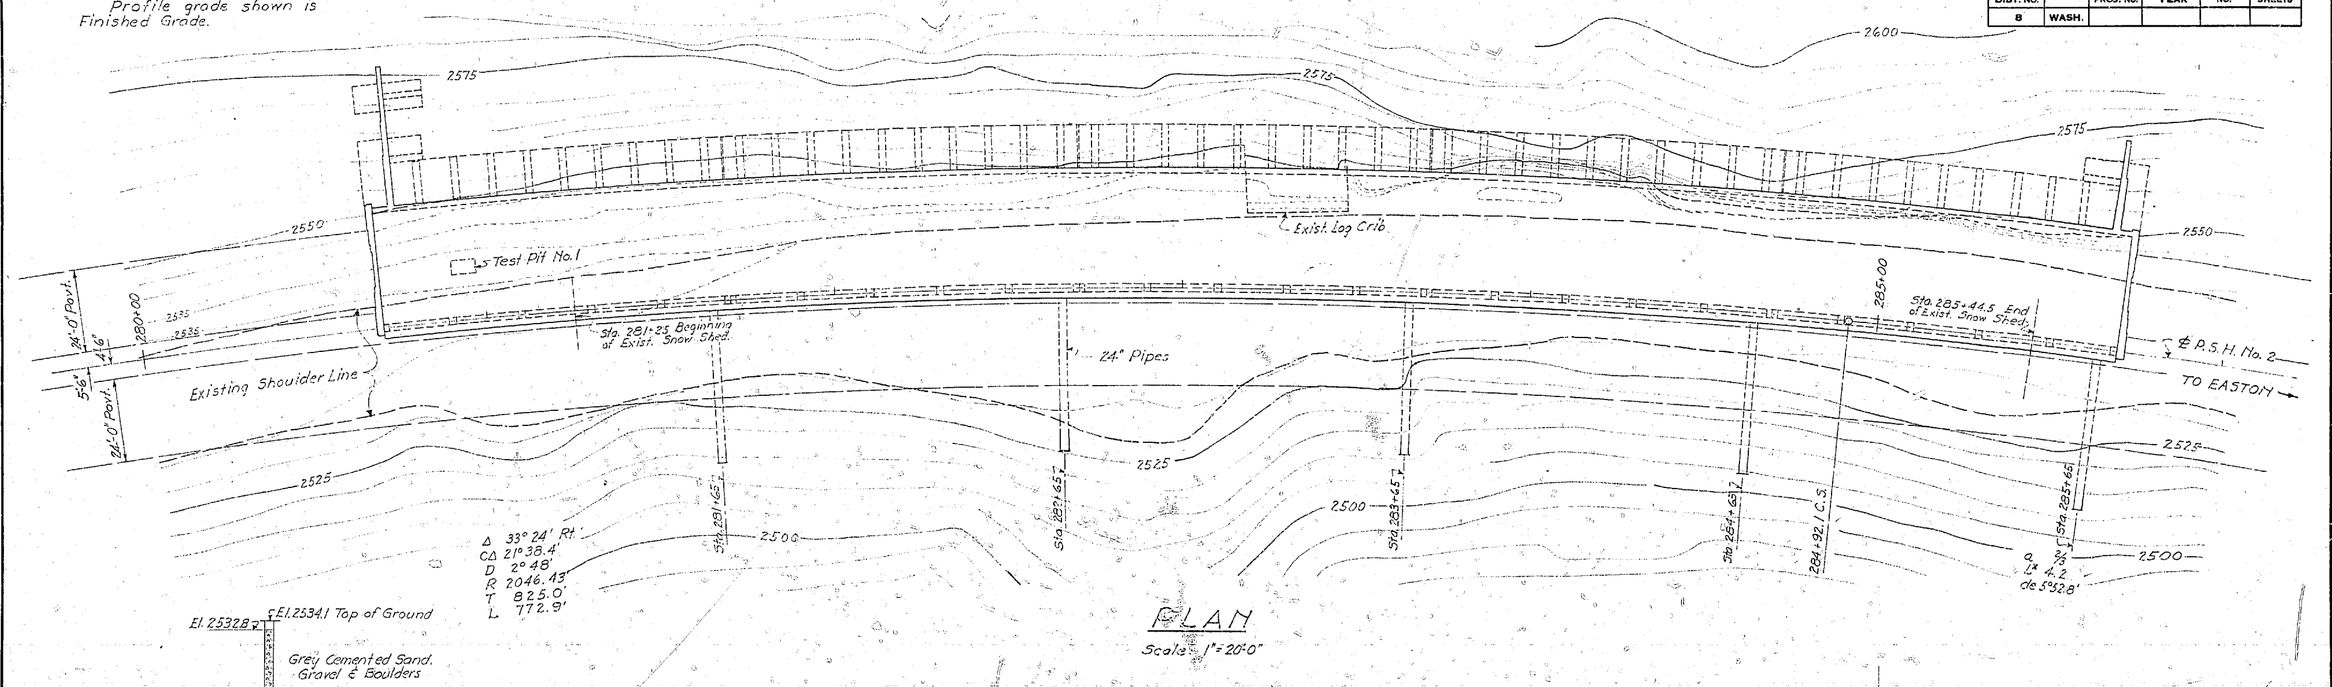

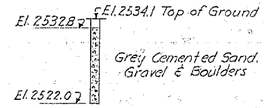

TEST PIT NO. 1

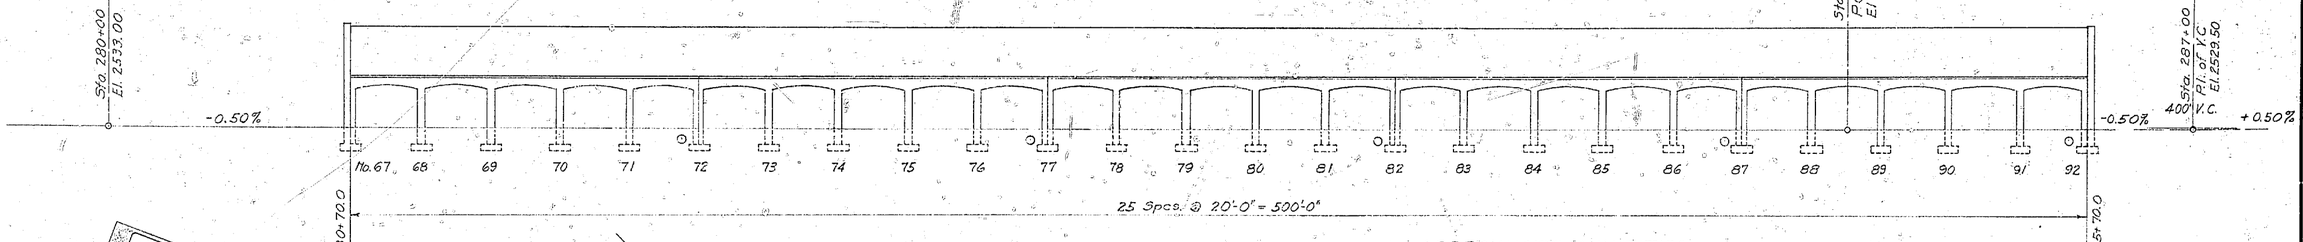

ELEVATION
(Developed along centerline)

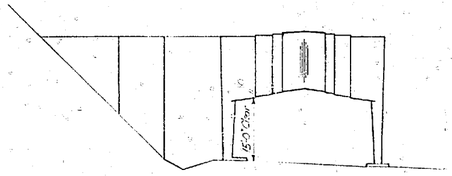

PORTAL

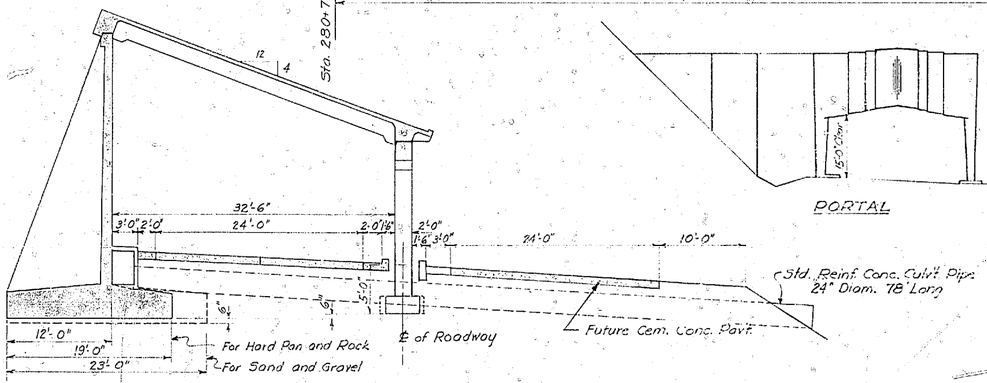

TYPICAL SECTION

APPROXIMATE QUANTITIES

ITEM NO.	ITEM	QUANTITY	UNIT
10	Structure Excavation	10,000	Cu. Yds
11	Mechanical Tampers	15	Days
12	Concrete Class "A"	1,200	Cu. Yds.
13	Concrete Class "B"	2,650	Cu. Yds.
14	Steel Reinforcing Bars	700,000	Pounds
15	Std. Reinf. Conc. Culv't Pipe 24" Diam	375	Lin. Ft.
16	Removing Existing Structure	Lump Sum.	

DATE	REVISION	BY	APP'R.
11-28-49	Edge of outside pav't to curb dimen. to 3'-0	P.Y.	O.R.D.

PRIMARY STATE HIGHWAY NO. 2
LAKE KEECHELUS SNOWSHED
KITTITAS COUNTY
STATE OF WASHINGTON
DEPARTMENT OF HIGHWAYS
OLYMPIA, WASHINGTON
APPROVED: Oct 11, 1949

O.R. DINSMORE — STATE OF WASHINGTON — REGISTERED PROFESSIONAL ENGINEER

ASST. DIRECTOR OF HIGHWAYS

SHEET 2 OF 2 SHEETS
CONTRACT NUMBER

72/185

FED. ROAD DIST. NO.	STATE	FED. AID PROJ. NO.	FISCAL YEAR	SHEET NO.	TOTAL SHEETS
8	WASH.	FI-002-2(1)		8	13

SEC. 35, T. 22 N., R. 11 E. W.M.

Note:
Profile grade shown is Finished Grade.
Use 2/3 Standard Superelevation
Roadway crowned 1/2" per foot on tangent. Crown eliminated on curves by uniform transition between S.T. and C.S.

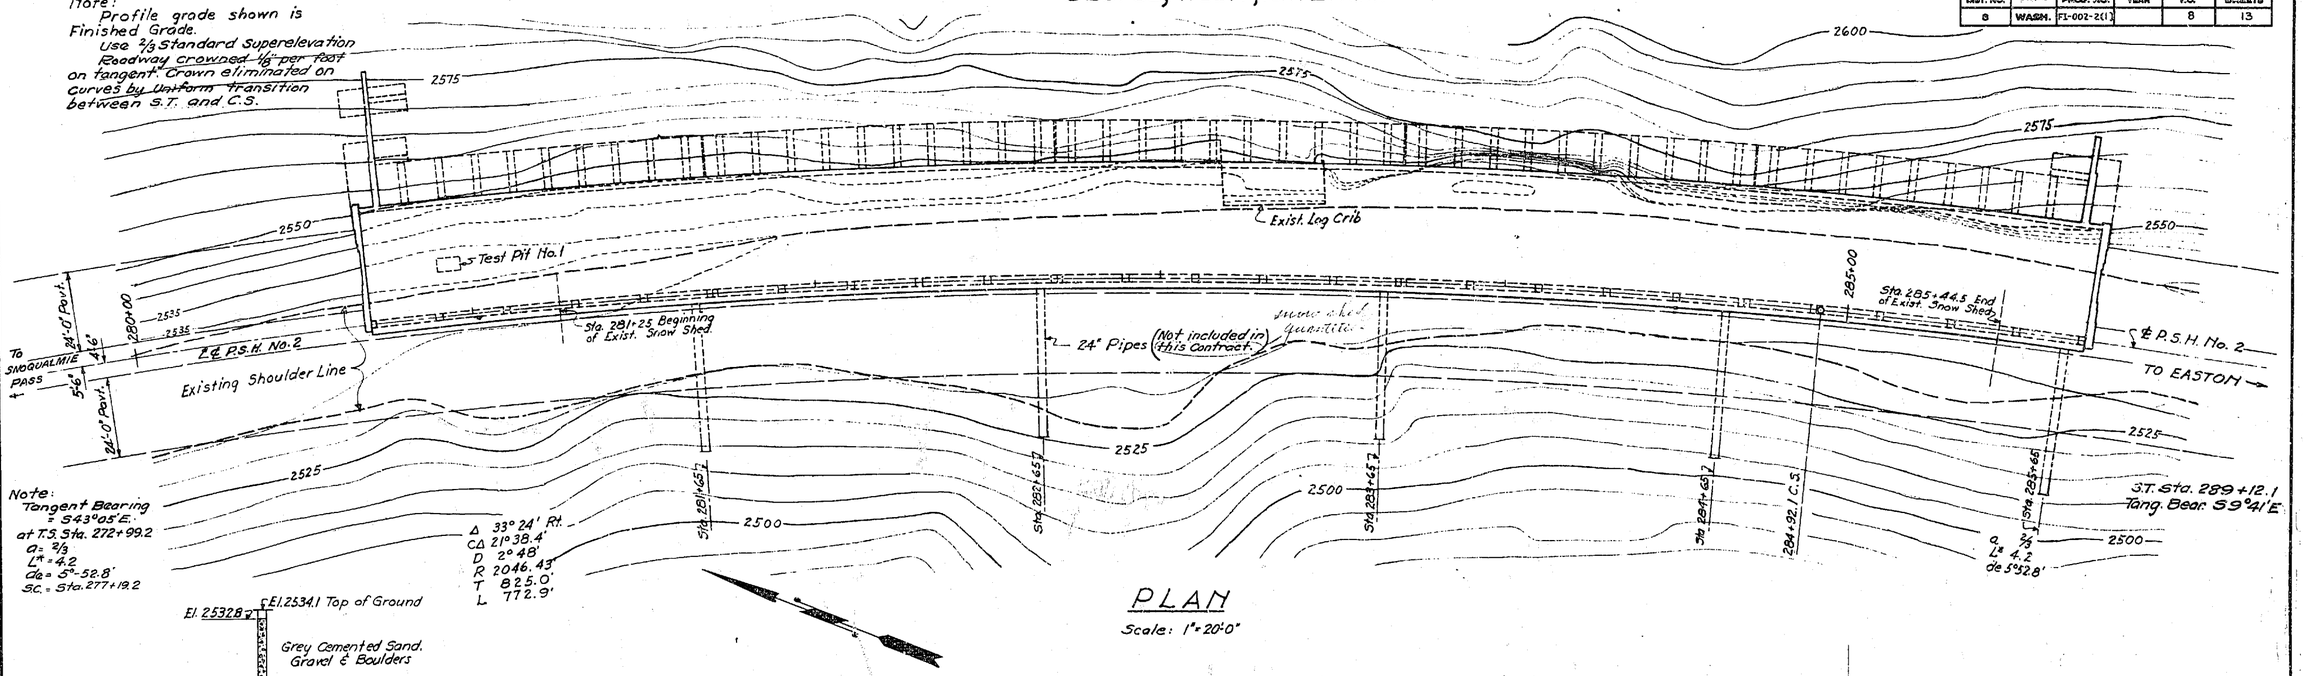

Note:
Tangent Bearing = S 43° 05' E. at P.T. Sta. 272+99.2
a = 2/3
L' = 4.2
de = 5°-52.8'
S.C. = Sta. 277+19.2

PLAN
Scale: 1" = 20'-0"

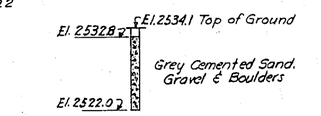

TEST PIT NO. 1

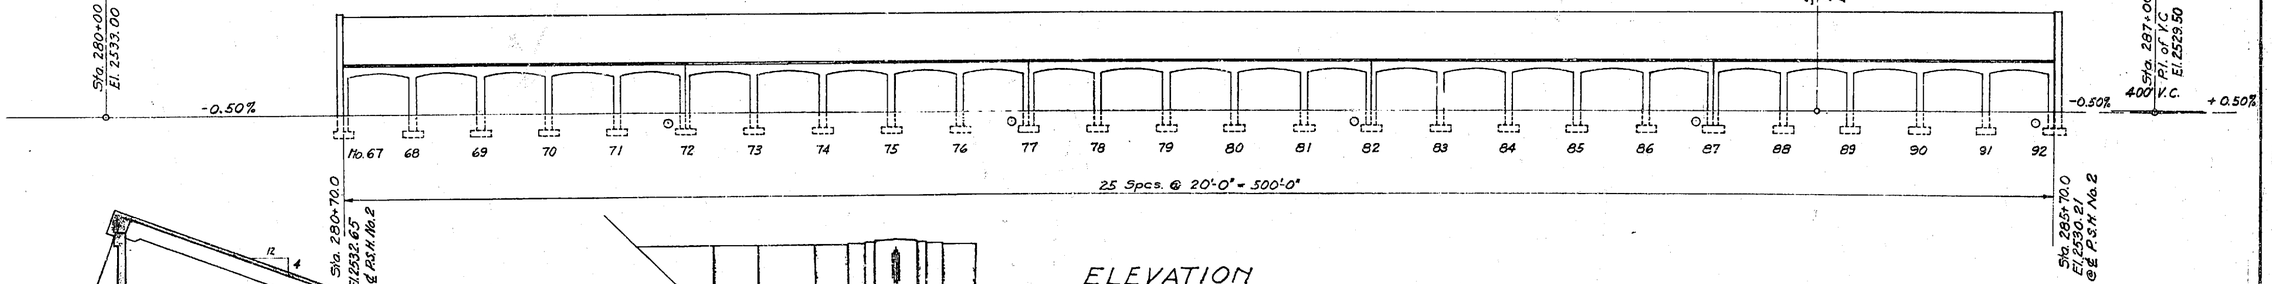

ELEVATION
(Developed along centerline)

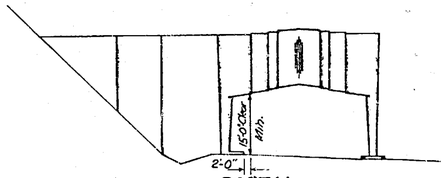

TYPICAL SECTION

PORTAL

PRIMARY STATE HIGHWAY NO. 2
AIRPLANE CURVE & LK. KEECHELUS SNOWSHEDS
KING & KITTITAS COUNTIES

LAYOUT - LK. KEECHELUS

STATE OF WASHINGTON
DEPARTMENT OF HIGHWAYS
OLYMPIA, WASHINGTON
APPROVED: JAN 31 1950
Asst. DIRECTOR OF HIGHWAYS

APPROVED:
BRIDGE ENGINEER

SHEET 10 OF 18 SHEETS
CONTRACT NUMBER 3754

S 685

72/194

Drawn by	C. C. N.	Oct. 1949
Traced by	B. Y.	Sept. 1949
Checked by	C. C. N.	Dec. "
Quantities Figured	P. Y.	Jan. 1950
Quantities Checked		

Designation Engineer	J.W. Hoover Jan. 1950
Designed	B.V. Sept. 1949
Design Checked	G.G.H. (E.C.E.) Sept. 1949
Drawn by	G.G.H. Oct. 1949
Quantities Figured	C.C.K. Dec. 1949
Quantities Checked	P.V. Jan. 1950

FED. ROAD DIST. NO.	STATE	FED. AID PROJ. NO.	FISCAL YEAR	SHEET NO.	TOTAL SHEETS
8	WASH.	F1-002-1(13)		7	11
		F1-002-2(1)		9	13

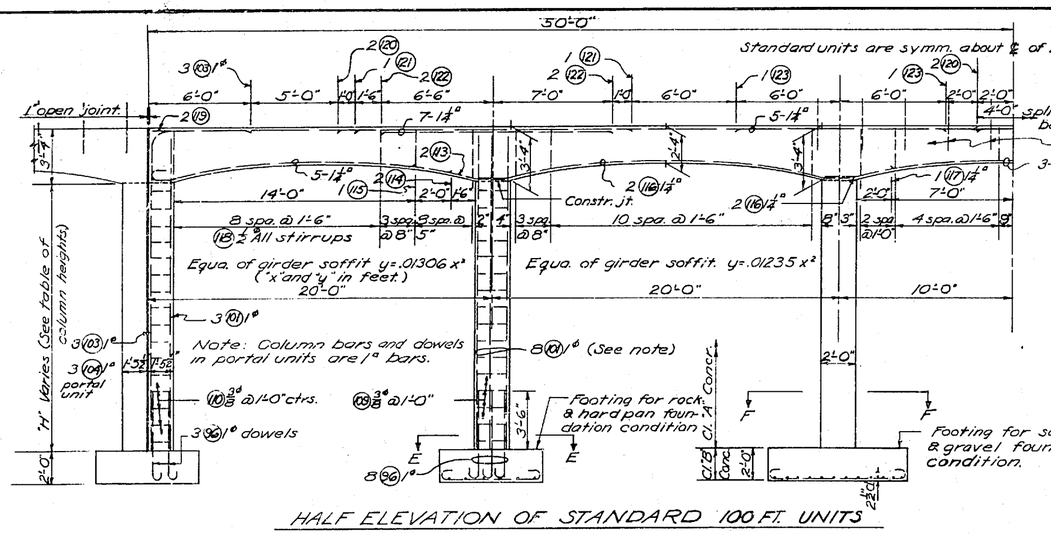

HALF ELEVATION OF STANDARD 100 FT. UNITS

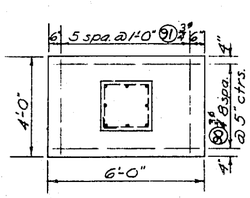

SECTION E-E

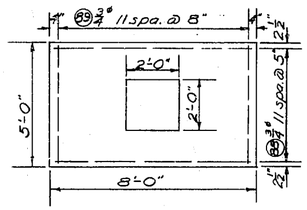

SECTION F-F

Scale ⅜" = 1'-0"

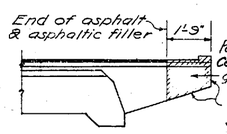

END DETAIL OF ROOF BEAMS
(except joint at 100' intervals.)

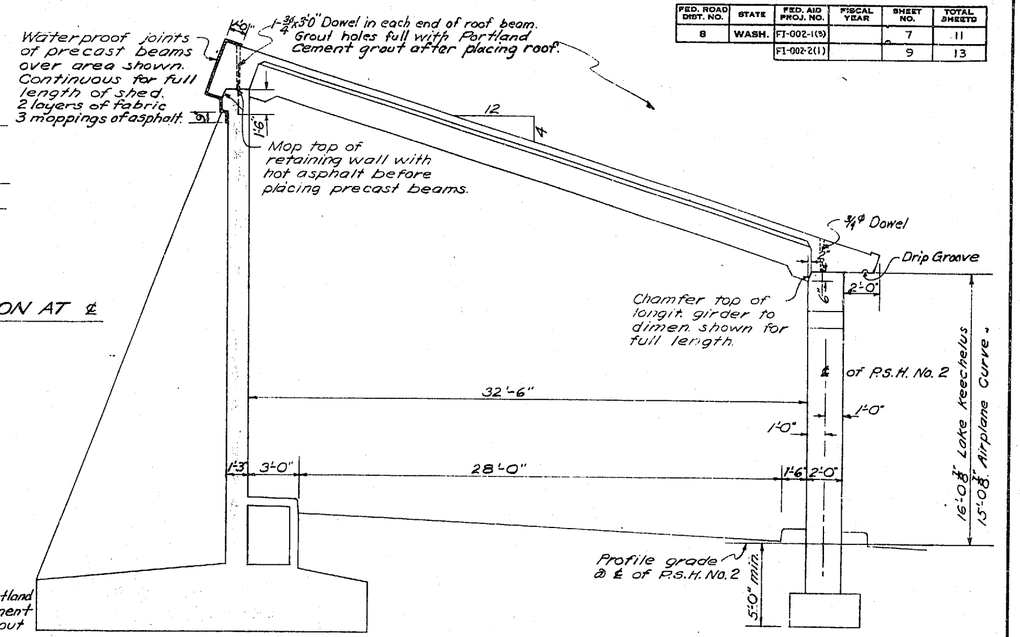

ELEVATION OF ASSEMBLED UNITS
Scale ¼" = 1'-0"

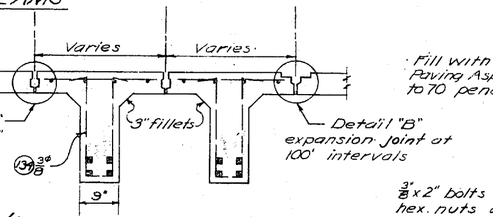

SECTION G-G
Scale ¾" = 1'-0"

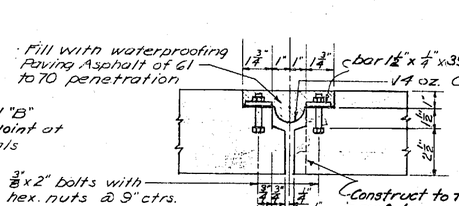

DETAIL "B"
Scale 1" = 1"

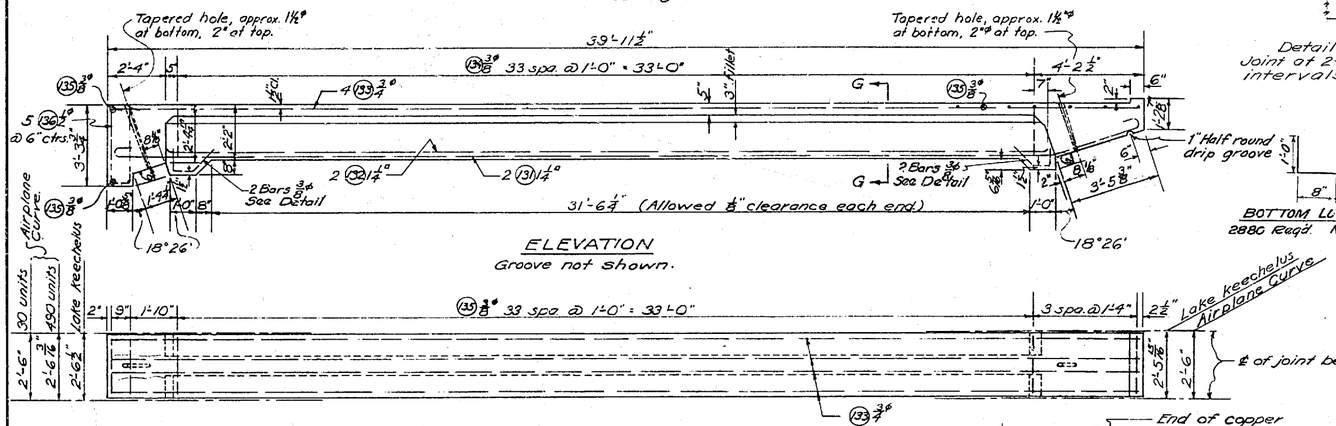

ELEVATION
Groove not shown.

PLAN
Scale ⅜" = 1'-0"

Note: Roof beams shall be lifted only with stem downward as in their final position and shall be supported at all times by blocks or slings placed not more than 10 feet from each end.

TYPICAL PRECAST ROOF BEAM
520 Units reqd at Airplane curve.
200 " " " Lake Keechelus.

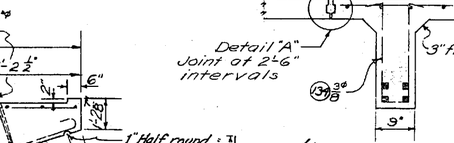

BOTTOM LUG STIRRUPS
288 Req'd. Not shown in Bar List.

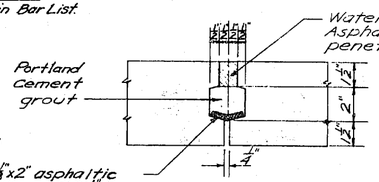

DETAIL "A"
Scale 1" = 1"

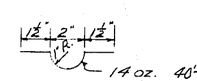

COPPER SEAL
16 required

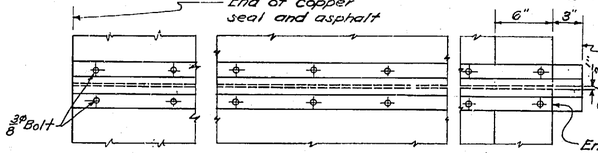

BEAM END DETAILS AT 100 FT. INTERVALS
Not to scale

5-18-50	Added bottom lug Stirrups in Rec'd Bms	P.Y.		W.H.R.
DATE	REVISION	BY	CHECKED	APPR.

PRIMARY STATE HIGHWAY NO. 2
AIRPLANE CURVE & LK. KEECHELUS SNOWSHEDS
KING & KITTITAS COUNTIES

ROOF & FRAME DETAILS

STATE OF WASHINGTON
DEPARTMENT OF HIGHWAYS
OLYMPIA, WASHINGTON
APPROVED JAN 30 1950
J.W. Hoover
ASST. DIRECTOR OF HIGHWAYS

APPROVED:
BRIDGE ENGINEER

SHEET 11 OF 18 SHEETS
CONTRACT NUMBER 3754

J. W. HOOVER STATE OF WASHINGTON REGISTERED PROFESSIONAL ENGINEER

WILLIAM A. BUGGE STATE OF WASHINGTON REGISTERED PROFESSIONAL ENGINEER

5/685

7/1/93

Designed	W.H.D. Jr. Engineer	Jan. 1948
Detailed		Sept. 1949
Traced	C.P.Y.	Sept. 1949
Checked		
Quantities Figured	C.C.N.	Dec. '49
Quantities Checked	P.Y.	Jan. 1950

FED. ROAD DIST. NO.	STATE	FED. AID PROJ. NO.	FISCAL YEAR	SHEET NO.	TOTAL SHEETS
8	WASH.	F1-002-1(5)		8	11
		F1-002-2(1)		10	13

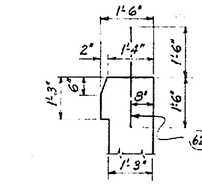

SECTION C-C

Scale: 1/2" = 1'-0"

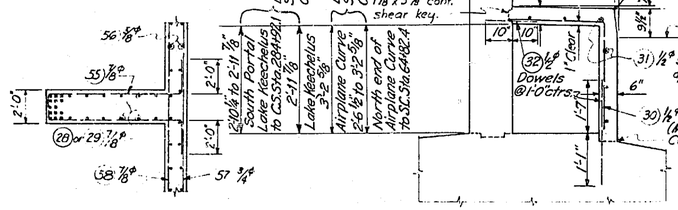

SECTION D-D

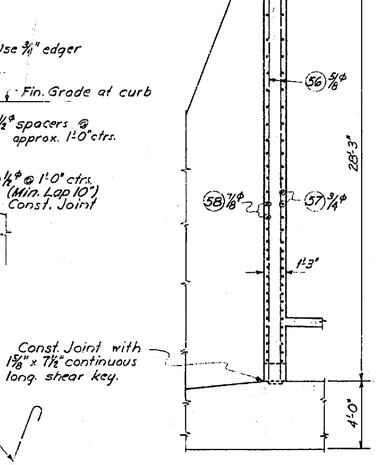

SECTION B-B

Scale: 1/2" = 1'-0"

SECTION A-A

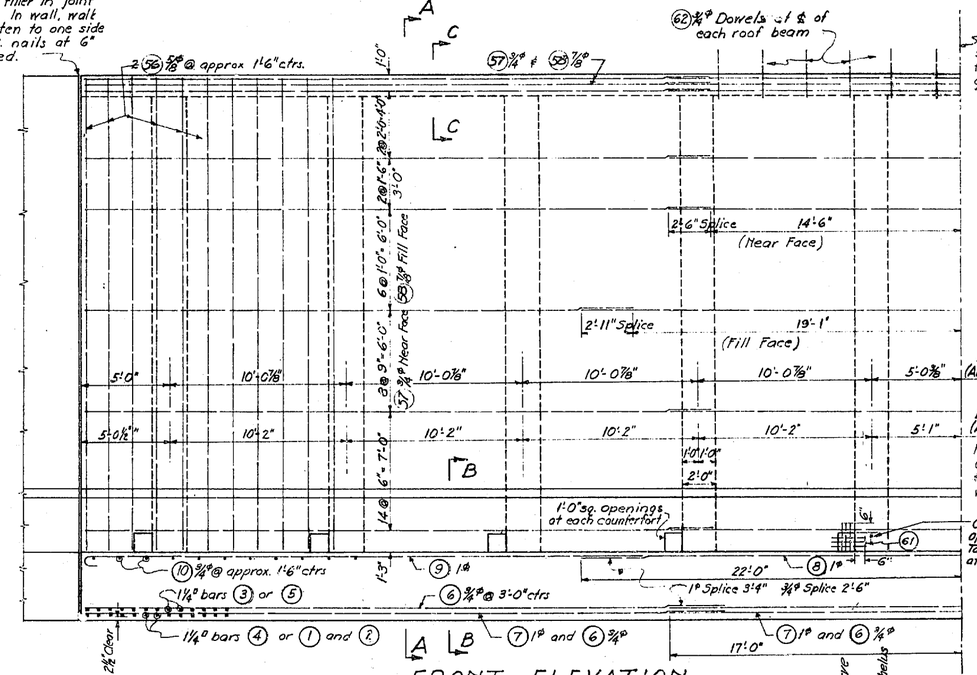

FRONT ELEVATION

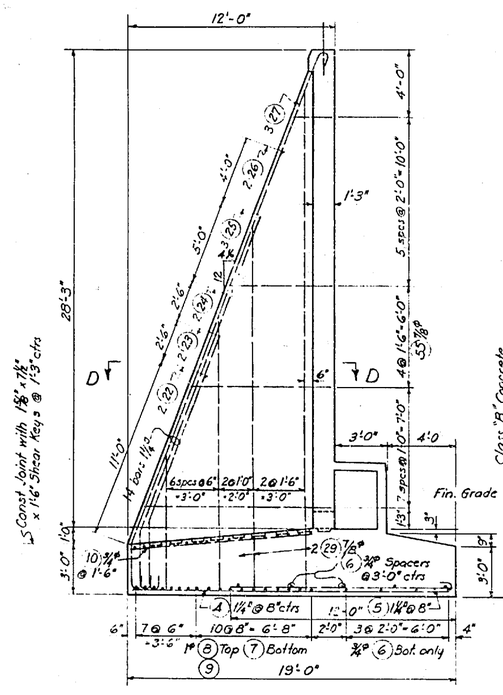

TYPICAL WALL SECTION

Sta. 281+70.0 to Sta. 285+70.0 (Lake Keechelus)
Sta. 69+50.0 to Sta. 76+50.0 (Airplane Curve)

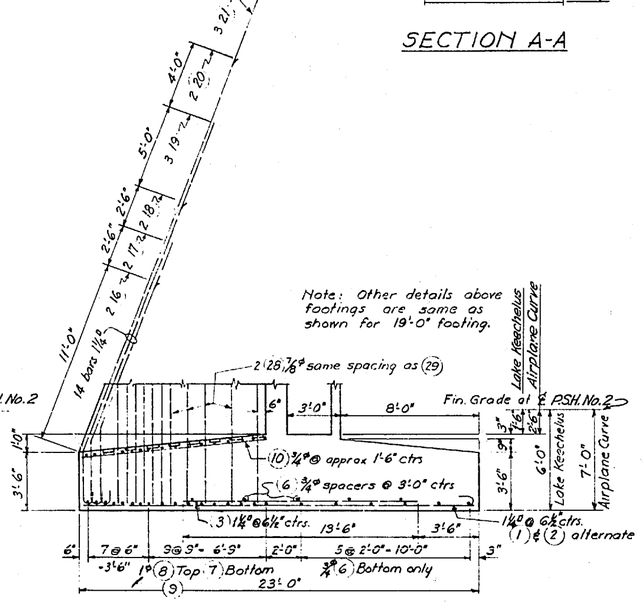

TYPICAL FOOTING SECTION

Sta. 280+70.0 to Sta. 281+70.0 (Lake Keechelus)

This footing section to be used on Airplane Curve only where suitable foundation material for the 19'-0" footing is not found.

Note: All scales 1/4" = 1'-0" except as noted.

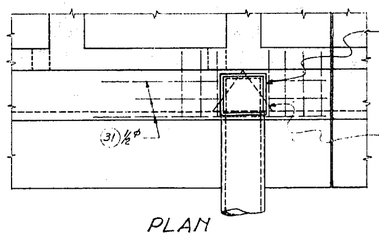

PLAN

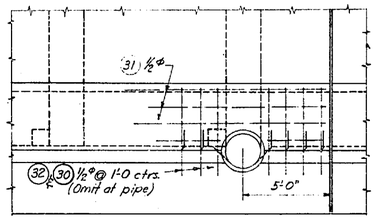

ELEVATION

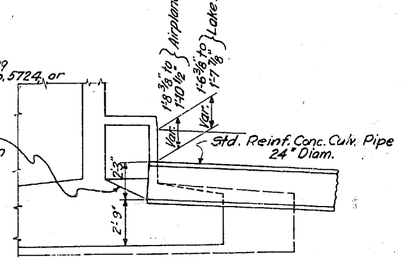

SECTION AT DRAIN

DETAIL OF DRAIN

24" Pipe drain and sidewalk manhole to be placed at lower end of each wall unit.

PRIMARY STATE HIGHWAY NO. 2

AIRPLANE CURVE & LK. KEECHELUS SNOWSHEDS

KING & KITTITAS COUNTIES

RETAINING WALL DETAILS

DATE	REVISION	BY	CHECKED	APPR.
4-12-50	Changed Bar (30) added (32) in Sidwk	P.Y.	C.C.N.	W.H.D. Jr.

J. W. HOOVER — STATE OF WASHINGTON — REGISTERED PROFESSIONAL ENGINEER

WILLIAM A. BUGGE — STATE OF WASHINGTON — REGISTERED PROFESSIONAL ENGINEER

STATE OF WASHINGTON
DEPARTMENT OF HIGHWAYS
OLYMPIA, WASHINGTON

APPROVED: MAR 10 1950

Asst. DIRECTOR OF HIGHWAYS

SHEET 12 OF 18 SHEETS

CONTRACT NUMBER 3754

APPROVED:

BRIDGE ENGINEER

S 685

Designing Engineer	W.P.Bakewell Jan.1950
Designed	C.C.W. Nov.1949
Design Checked	P.Y. (E.C.K.) " "
Drawn by	C.C.W. " "
Quantities Figured	C.C.W. Dec. 1950
Quantities Checked	P.Y. Jan. 1950

FED. ROAD DIST. NO.	STATE	FED. AID PROJ. NO.	FISCAL YEAR	SHEET NO.	TOTAL SHEETS
6	WASH.	F1-002-2(1)		11	13

ELEVATION OF NORTH PORTAL LAKE KEECHELUS

SECTION L-L

SECTION M-M

SECTION N-N

PORTAL SCORING DETAIL

SECTION "H-H"

SECTION J-J

SECTION K-K

SECTION O-O

SECTION P-P

PLAN

SECTION I-I

(Same for South Portal except where noted)

VOID See Sheet 15A

VOID See Sheet 15A

Back of retaining wall

Level El. 2562.45

Level El. 2562.47

Level

Const. joint

Note: For details not shown see "Elev. of South Portal Lake Keechelus"

Profile grade @ ℄ of P.S.H. No. 2

Top of curb

Batter ¼" to 1'-0"

Batter ⅛" to 1'-0"

Cl. "B" Concr.

Const. joint with 1⅝" x 4½" shear keys @ 1'-3" ctrs.

Const. jt. with 1⅝" x 7½" shear key

Const. joint with 1⅝" x 7½" shear key @ 1'-3" ctrs.

14 (98) 1¼" Dowels

El. 2527.65

El. 2527.15 @ Sta. 280+70.0

El. 2533.20

For reinforcement see 19'-0" "Typical Footing Section."

El. 2527.13 Sta. 280+75.0

El. 2524.73 @ Sta. 285+65.0

Sta. 280+70

TOP STEEL

BOTT. STEEL

Hook ends

Cut face of wall

3 R.

Varies

8-15-50	North Endwall	P.Y.	C.C.W.	
DATE	REVISION	BY	C'K'D	APPROVED

PRIMARY STATE HIGHWAY NO. 2

AIRPLANE CURVE & L.K. KEECHELUS SNOWSHEDS

KING & KITTITAS COUNTIES

NORTH PORTAL - L.K. KEECHELUS

STATE OF WASHINGTON
DEPARTMENT OF HIGHWAYS
OLYMPIA, WASHINGTON
APPROVED JUNE 30, 1950

J. W. HOOVER
STATE HIGHWAY ENGINEER

SHEET 15 OF 18 SHEETS
CONTRACT NUMBER 3754

APPROVED:
BRIDGE ENGINEER

J. W. HOOVER — STATE OF WASHINGTON — REGISTERED PROFESSIONAL ENGINEER

WILLIAM A. BUGGE — STATE OF WASHINGTON — REGISTERED PROFESSIONAL ENGINEER

S 685

FED. ROAD DIST. NO.	STATE	FED. AID PROJ. NO.	FISCAL YEAR	SHEET NO.	TOTAL SHEETS
8	WASH.	I-002-2(1)			

Designing Engineer	W.D. Hatcher	Aug. 1950
Designed	C. H.	Aug. 1950
Detailed and checked	C. Y.	Aug. 1950
Drawn by		
Quantities Figured		
Quantities Checked		

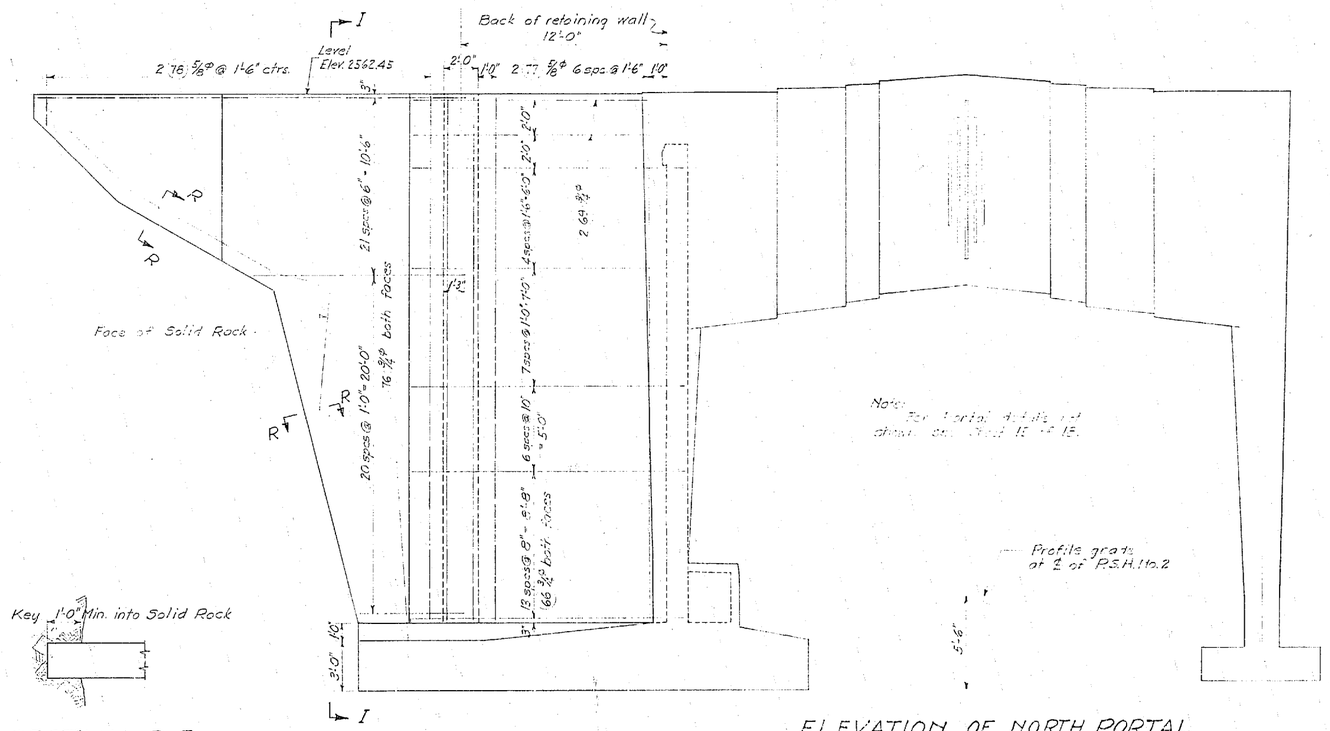

SECTION R-R

ELEVATION OF NORTH PORTAL
LAKE KEECHELUS

Scale: 1/4" = 1'-0"

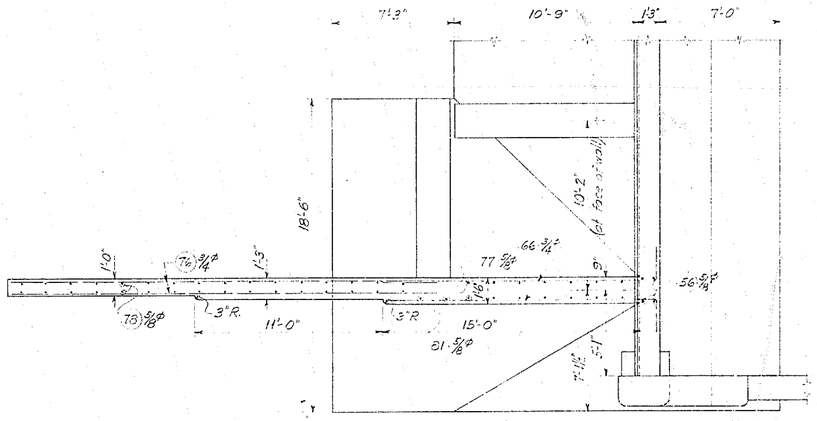

PART PLAN

Note:
Endwall details shown here supersede those shown on Sheet 15 of 18 sheets.

PRIMARY STATE HIGHWAY NO. 2
AIRPLANE CURVE & LK. KEECHELUS SNOWSHEDS
KING & KITTITAS COUNTIES

REVISED NORTH PORTAL - LAKE KEECHELUS

STATE OF WASHINGTON
DEPARTMENT OF HIGHWAYS
OLYMPIA, WASHINGTON

APPROVED AUGUST 1950

George Stevens
BRIDGE ENGINEER

SHEET 15-A OF 18 SHEETS
CONTRACT NO. 3754

72/188A

DIETZGEN-POST CO. PRINTED ON CLEARPRINT NO. 1000H

Designed Engineer	W. W. Hoover, Jan. 1950
Detailed	C.C.N. & P.Y. Nov. 1949
Design Checked (Rock)	P.Y. & C.C.N. Dec. "
Drawn by	C.C.N. " "
Quantities Figured	C.C.N. " "
Quantities Checked	P.Y. Jan. 1950

FED. ROAD DIST. NO.	STATE	FED. AID PROJ. NO.	FISCAL YEAR	SHEET NO.	TOTAL SHEETS
6	WASH.	FI-002-2(1)		12	13

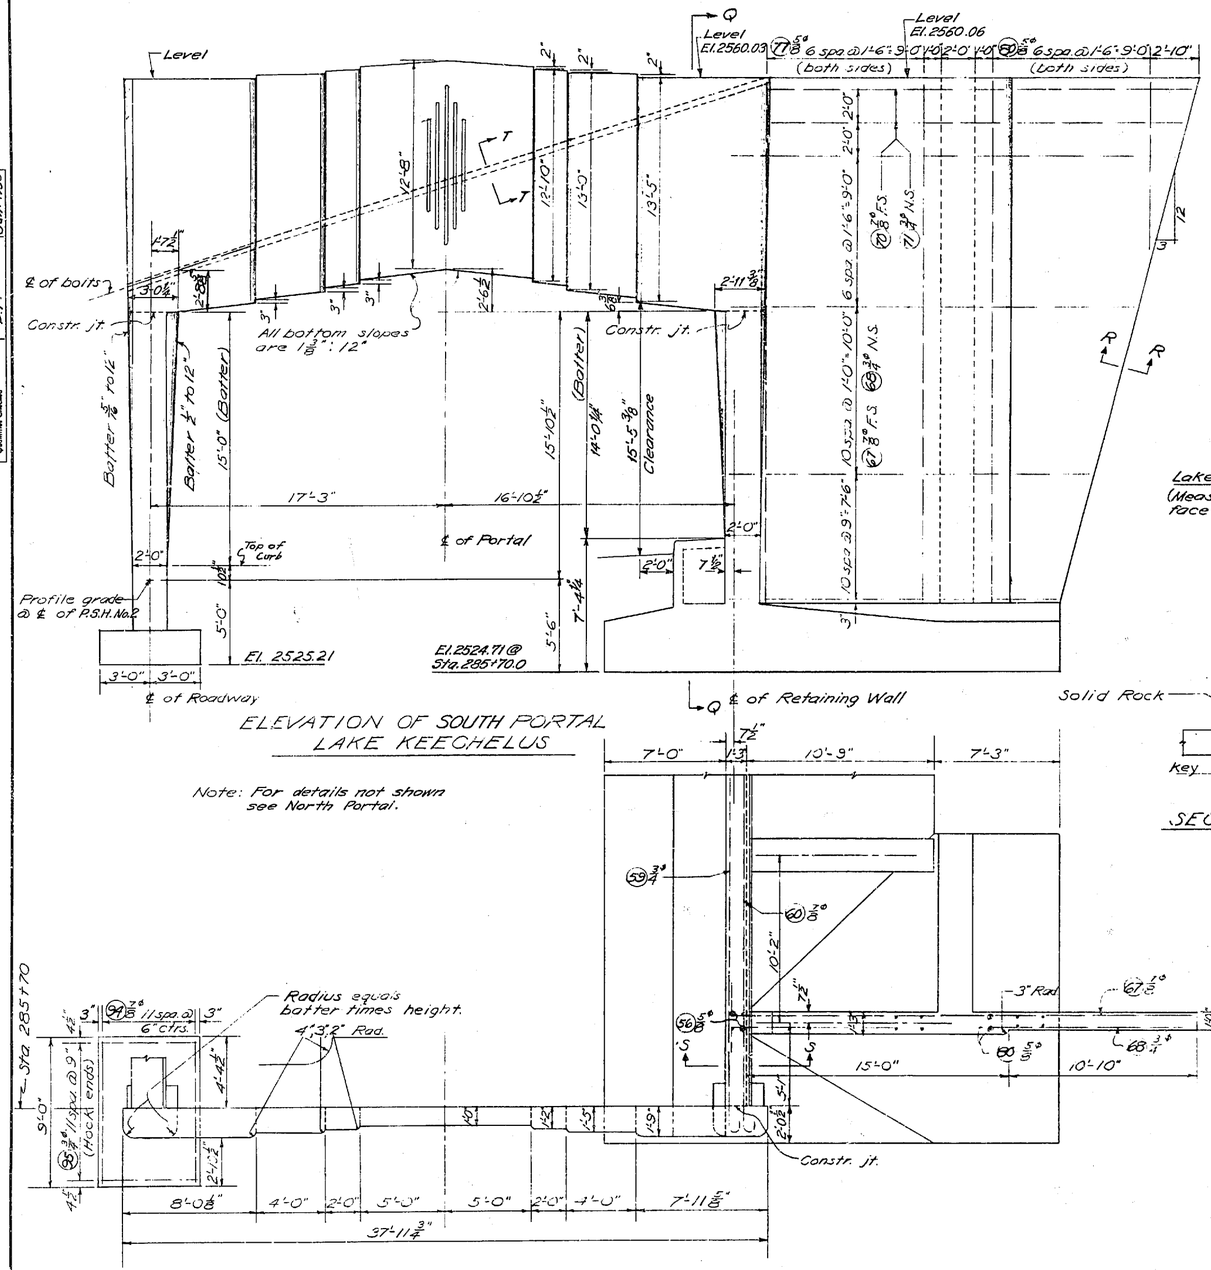
Level
Level
El. 2560.03
Level
El. 2560.06
(77) 5/8" @ 6 spa. @ 1'-6"; 9 spa. @ 1'-0"; 2 spa. @ 2'-0"; 1 spa. @ 1'-0"
(58) 5/8" @ 6 spa. @ 1'-6"; 9 spa. @ 1'-0"; 2 spa. @ 2'-10"
(both sides)
(both sides)
12:45"
12'-10"
13'-0"
13'-5"
2'-0"
2'-0"
2'-0

Designing Engineer	W.H.P.	Submitted	Nov. 1949
Designed	P.Y.	C.C.N. (1951)	"
Detailed	C.C.N.	C.C.N.	Dec. "
Checked	C.C.N.	C.C.N.	"
Drawn by	C.C.N.	C.C.N.	"
Quantities Figured	P.Y.	C.C.N.	Jan. 1950
Quantities Checked	P.Y.		

FED. ROAD DIST. NO.	STATE	FED. AID PROJ. NO.	FISCAL YEAR	SHEET NO.	TOTAL SHEETS
6	WASH.	FI-002-2(1)		13	13

Note:
Other details are same
as for Standard 100' units

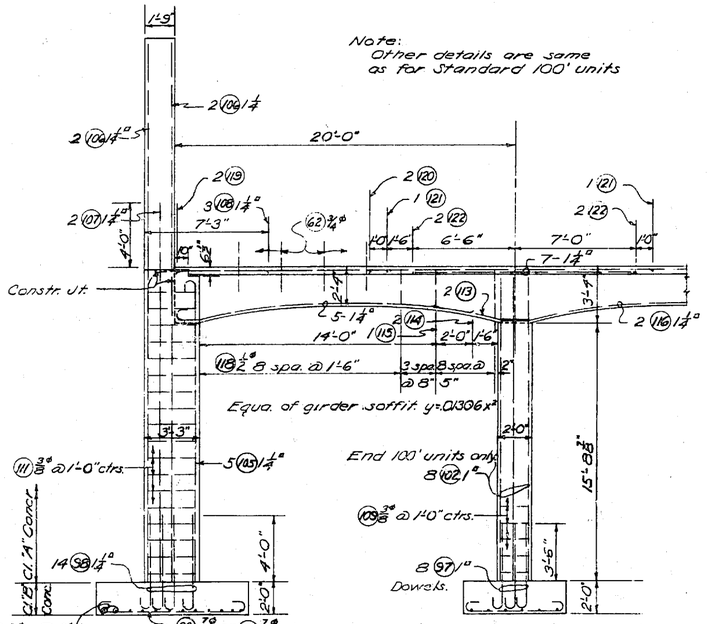

PART INSIDE ELEV. OF PORTAL UNIT

BAR LIST ~ LAKE KEECHELUS

All dimensions are out to out

Mark	Location	No.	Size	Length	Bending Diagram
1	Wall footing bott. trans.	96	1¼"	23'-3"	
2	" " " "	95	1¼"	22'-6"	Str.
3	" " " "	191	1¼"	13'-6"	"
4	" " " "	611	1¼"	19'-9"	"
5	" " " "	611	1¼"	12'-9"	Str.
6	" " " Spacers	141	⅜"	Varies	" 47 @ 34'-0", 74 @ 36'-0" & 20 @ 35'-2"
7	" " " Longit.	267	1"	Varies	" 89 @ 34'-0", 143 @ 36'-10" & 35 @ 39'-0"
8	" " Top Longit.	89	1"	44'-0"	"
9	" " " "	178	1"	Varies	
10	" " " Spacers	342	⅜"	10'-6"	Str.
11	Portal " Bott. Longit.	20	1¼"	11'-6"	
12	" " " Transv.	14	⅜"	7'-9"	Str.
13	" " Top "	28	⅝"	8'-8"	
14	" " " Longit.	10	¾"	10'-9"	Str.
16	Wall Counterforts ~ Back	18	1¼"	15'-2"	
17	" " "	18	1¼"	17'-8"	
18	" " "	18	1¼"	20'-3"	
19	" " "	27	1¼"	25'-3"	
20	" " "	18	1¼"	29'-5"	
21	" " "	27	1¼"	36'-9"	
22	" " "	78	1¼"	14'-5"	
23	" " "	78	1¼"	17'-2"	
24	" " "	78	1¼"	19'-9"	
25	" " "	117	1¼"	24'-9"	
26	" " "	78	1¼"	28'-11"	
27	" " "	117	1¼"	36'-3"	
28	" " Vertical	198	⅝"	Varies	Str. 18 ea. size vary 8'-6" to 29'-10" ave. 16'-3"
29	" " "	858	⅝"	Varies	" 78 " " 8'-0" to 29'-4" ave. 16'-3"
30	Sidewalk Transv.	50	½"	5'-6"	
31	" Longit.	135	½"	Varies	Str. 90 @ 30'-0", 6 @ 18'-4", 9 @ 16'-3", 3 @ 12'-0"
					12 @ 10'-0", 3 @ 5'-6" & 12 @ 3'-6"
32	Sidewalk Dowels	1020	½"	Varies	Str. 510 ea. @ 1'-8" & 2'-8"

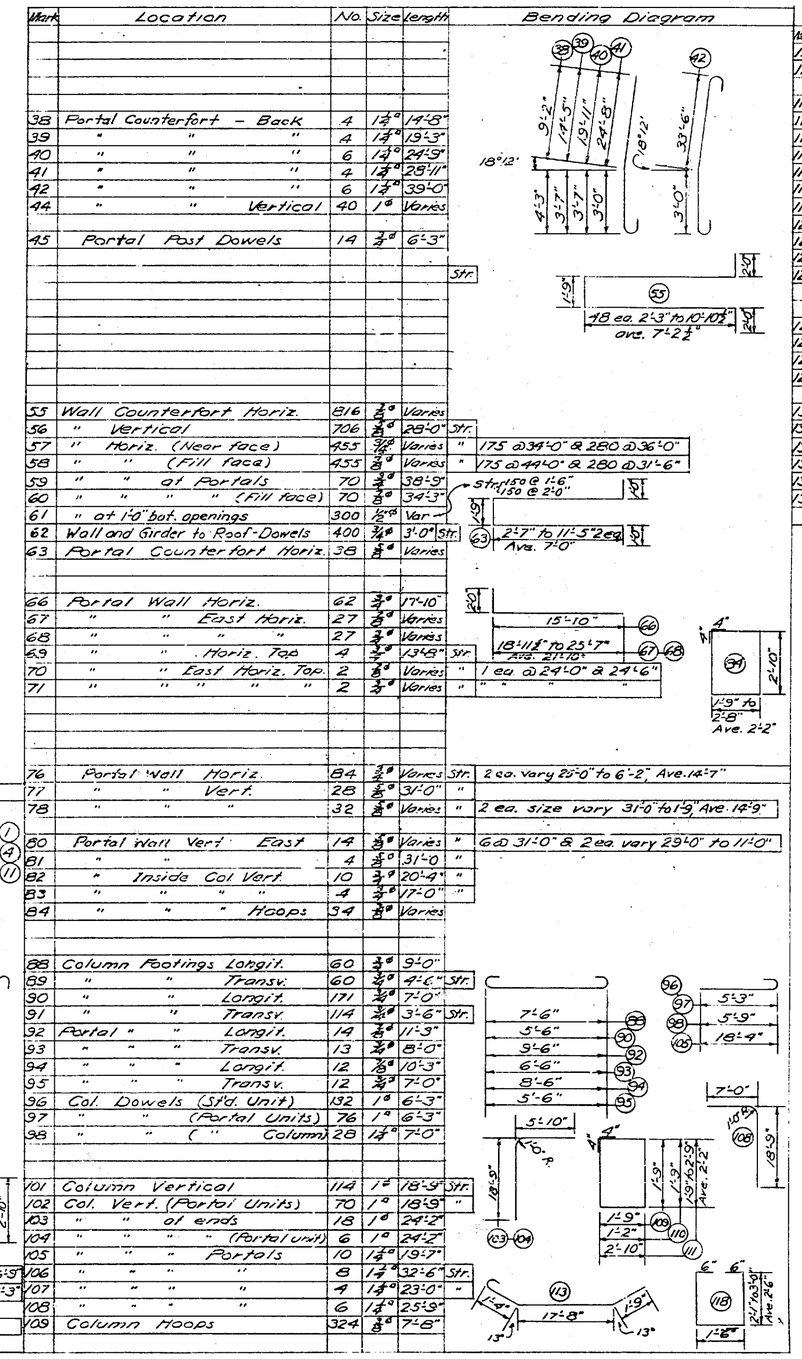

Mark	Location	No.	Size	Length	Bending Diagram
38	Portal Counterfort ~ Back	4	1¼"	14'-8"	
39	" " "	4	1¼"	19'-3"	
40	" " "	6	1¼"	24'-5"	
41	" " "	4	1¼"	28'-11"	
42	" " "	6	1¼"	33'-0"	
44	" " Vertical	40	1"	Varies	
45	Portal Post Dowels	14	¾"	6'-3"	Str.
55	Wall Counterfort Horiz.	816	⅝"	Varies	
56	" Vertical	706	⅝"	28'-0"	Str.
57	" Horiz. (Near face)	455	⅝"	Varies	" 175 @ 34'-0" & 280 @ 36'-0"
58	" " (Fill face)	455	⅝"	Varies	" 175 @ 44'-0" & 280 @ 31'-6"
59	" " at Portals	70	¾"	38'-9"	Str. #5 at 1'-6" & #50 @ 2'-0"
60	" " " (Fill face)	70	⅝"	34'-3"	
61	" at 1'-0" bot. openings	300	½"	Var	
62	Wall and Girder to Roof ~ Dowels	400	¾"	3'-0"	Str. 2'-7" to 11'-5" 2 eq. Ave. 7'-0"
63	Portal Counterfort Horiz.	38	⅝"	Varies	
66	Portal Wall Horiz.	62	¾"	17'-10"	
67	" " East Horiz.	27	⅝"	Varies	
68	" " "	27	¾"	Varies	
69	" " Horiz. Top	4	¾"	13'-8"	Str.
70	" " East Horiz. Top	2	⅝"	Varies	" 1 ea @ 24'-0" & 24'-6"
71	" " " " "	2	¾"	Varies	" " " " "
76	Portal Wall Horiz.	84	¾"	Varies	Str. 2 ea. vary 25'-0" to 6'-2", Ave. 14'-7"
77	" " Vert.	28	⅝"	31'-0"	"
78	" " "	32	⅝"	Varies	" 2 ea. size vary 31'-0" to 19", Ave. 12'-9"
80	Portal Wall Vert. East	14	⅝"	Varies	" 6 @ 31'-0" & 2 ea. vary 29'-0" to 11'-0"
81	" "	4	⅝"	31'-0	"
82	" Inside Col. Vert.	10	¾"	20'-4"	"
83	" " " "	4	¾"	17'-0"	"
84	" " " Hoops	34	⅝"	Varies	
88	Column Footings Longit.	60	¾"	9'-0"	
89	" " Transv.	60	⅝"	4'-6"	Str.
90	" " Longit.	171	⅝"	7'-0"	
91	" " Transv.	1114	⅝"	3'-6"	Str.
92	Portal " " Longit.	14	⅝"	11'-3"	
93	" " " Transv.	13	⅝"	8'-0"	
94	" " " Longit.	12	⅝"	10'-3"	
95	" " " Transv.	12	⅝"	7'-0"	
96	Col. Dowels (Std. Unit)	132	1"	6'-3"	
97	" " (Portal Units)	76	1"	6'-3"	
98	" " (" Columns)	28	1¼"	7'-0"	
101	Column Vertical	114	1"	18'-3"	Str.
102	Col. Vert. (Portal Units)	70	1"	18'-9"	"
103	" " at ends	18	1"	24'-2"	
104	" " " (Portal unit)	6	1"	24'-2"	
105	" " " Portals	10	1¼"	19'-7"	
106	" " " "	8	1¼"	32'-6"	Str.
107	" " " "	4	1¼"	23'-0"	"
108	" " "	6	1¼"	25'-9"	
109	Column Hoops	324	⅝"	7'-8"	

Mark	Location	No.	Size	Length	Bending Diagram
110	Col. hoops @ end of unit	128	⅝"	6'-6"	
111	" " " Portal	38	⅝"	Varies	
113	Longit. Girder Bott.	20	1¼"	22'-0"	
114	" " "	20	1¼"	18'-9"	
115	" " "	10	1¼"	16'-8"	
116	" " "	30	1¼"	21'-8"	
117	" " "	5	1¼"	14'-0"	Str.
118	" " Stirrups	410	⅝"	Varies	
119	" " Top	20	1¼"	52'-0"	Str.
120	" " "	20	1¼"	37'-0"	"
121	" " "	10	1¼"	16'-0"	"
122	" " "	20	1¼"	13'-6"	"
123	" " "	10	1¼"	12'-0"	"
126	Portal Bott.	4	1"	38'-10"	
127	" Top	4	1"	49'-8"	
128	" Horiz.	24	⅝"	36'-9"	Str.
129	" Vert.	50	½"	Varies	
131	Roof Beam longit. Bott.	400	1¼"	42'-3"	
132	" " " "	400	1¼"	34'-0"	Str.
133	" " " Top.	800	⅝"	39'-5"	"
134	" " Stirrups	6800	⅝"	5'-4"	
135	" " Transv.	8200	⅝"	2'-2"	Str.
136	" " End stirrups	1000	½"	7'-7"	

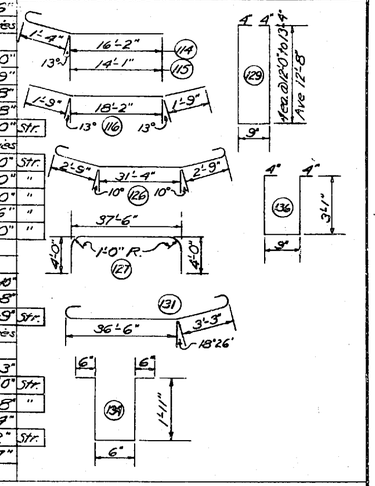

C.C.N.	P.Y.	8-15-50	North End wall and Footing
C.C.N.	P.Y.	4-12-50	Changed Bar (62) added Bar (62)
CHECKED	BY	DATE	REVISION

PRIMARY STATE HIGHWAY NO. 2
AIRPLANE CURVE & LK. KEECHELUS SNOWSHEDS
KING & KITTITAS COUNTIES

BAR LIST & END FRAME
LAKE KEECHELUS

STATE OF WASHINGTON
DEPARTMENT OF HIGHWAYS
OLYMPIA, WASHINGTON

APPROVED: JAN 30 1950
Asst. Chief Engineer of Highways

APPROVED:
Bridge Engineer

J. W. HOOD — STATE OF WASHINGTON — REGISTERED PROFESSIONAL ENGINEER

WILLIAM A. BUGGE — STATE OF WASHINGTON — REGISTERED PROFESSIONAL ENGINEER

SHEET 18 OF 18 SHEETS
CONTRACT NUMBER 3754

2/685

FED. ROAD DIST. NO.	STATE	FED. AID PROJ. NO.	FISCAL YEAR	SHEET NO.	TOTAL SHEETS
8	WASH.				

Designed	G.H.A.	April '51
Detailed		
Checked		
Drawn by		
Quantities Checked		

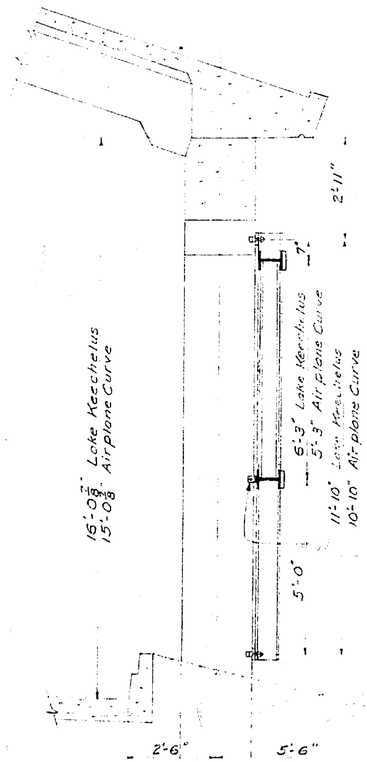

SECTION "A-A"

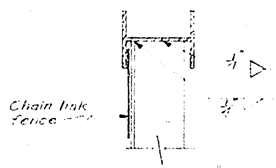

SECTION "C-C"

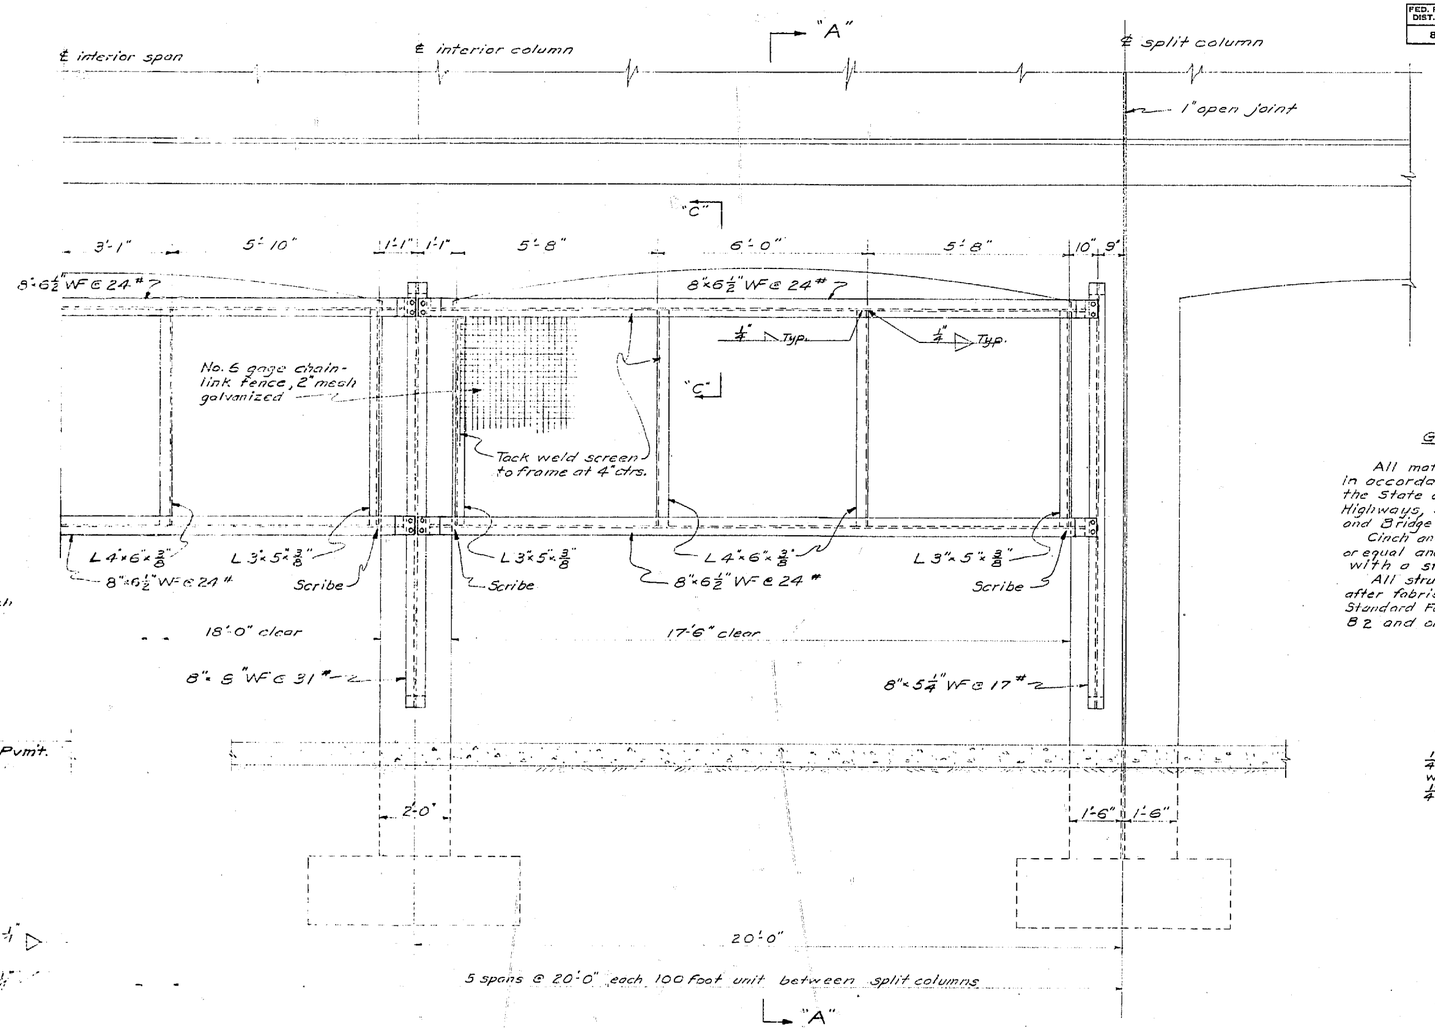

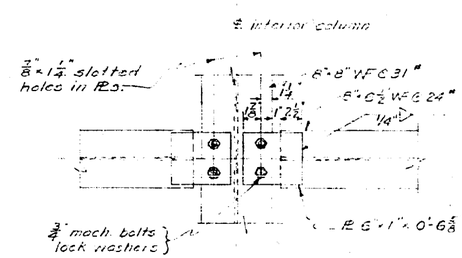

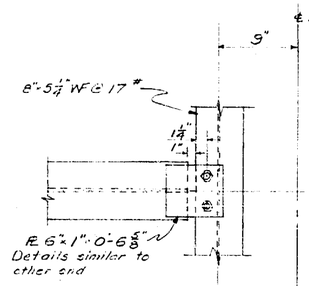

FRAME END CONNECTION DETAILS

ELEVATION

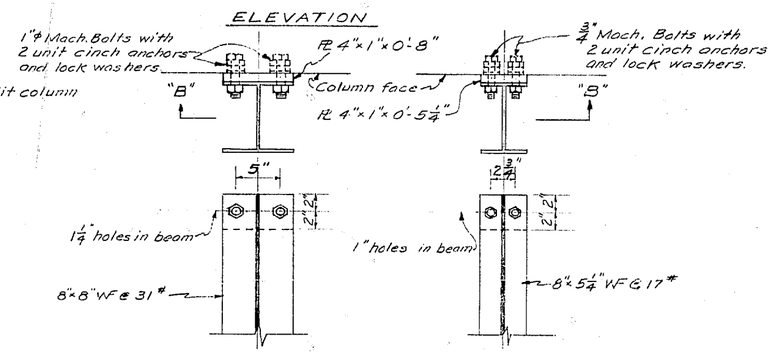

SECTION "B-B"

VERTICAL BEAM CONNECTION

Bottom connection similar

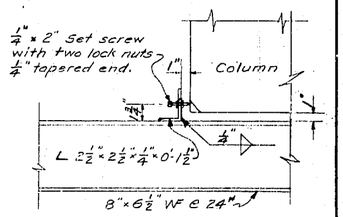

SCRIBE DETAIL

After installing frame, tighten set screws firmly against column and set lock nuts

GENERAL NOTES

All material and workmanship shall be in accordance with the requirements of the State of Washington, Department of Highways, Standard Specifications for Road and Bridge Construction, Dated April 1948

Cinch anchors shall be National Lead Co. or equal and holes shall be drilled in columns with a star concrete drill.

All structural steel shall be painted, after fabricating, one first coat of State Standard Formula A2, one second coat of B2 and one final coat of Grey C3.

PRIMARY STATE HIGHWAY NO. 2
AIRPLANE CURVE & LK. KEECHELUS SNOWSHEDS
KING & KITTITAS COUNTIES

SNOW FENCE

STATE OF WASHINGTON
DEPARTMENT OF HIGHWAYS
OLYMPIA, WASHINGTON

APPROVED:

DIRECTOR OF HIGHWAYS — BRIDGE ENGINEER

72/195-A

DIETZGEN-POST CO. PRINTED ON CLEARPRINT NO. 1000H

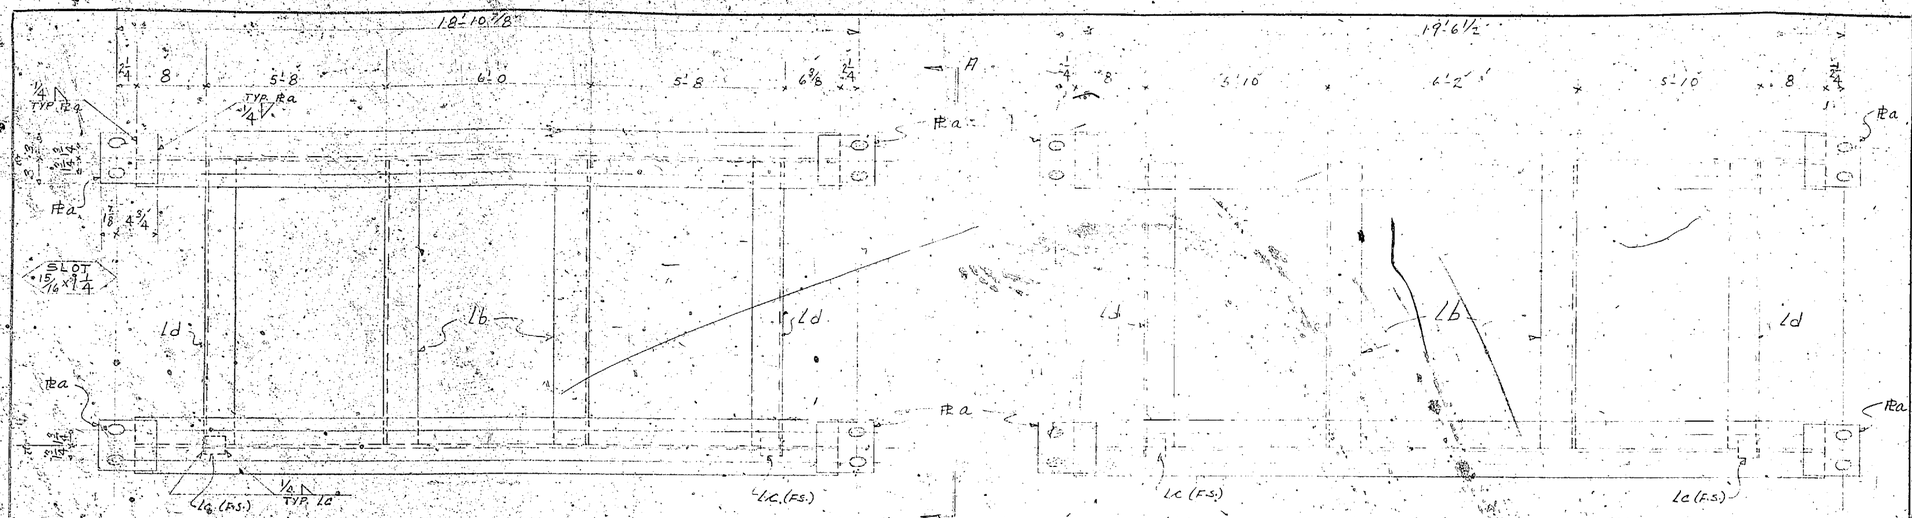

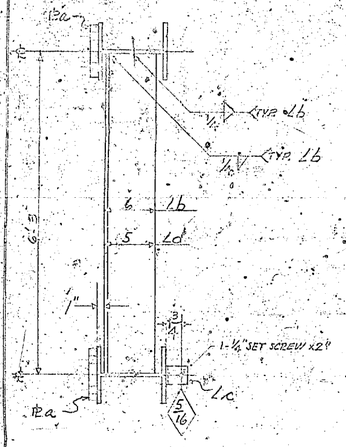

SECT. A-A
TYP. F1, F2 & F3

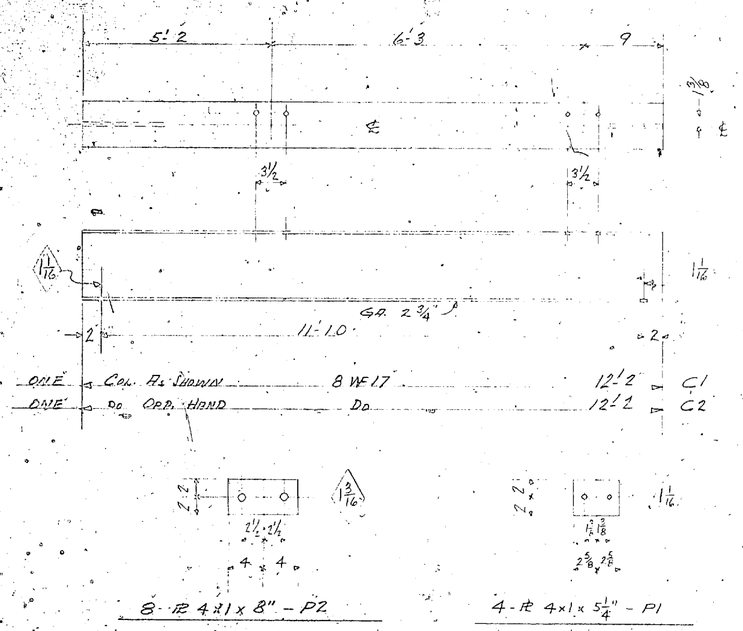

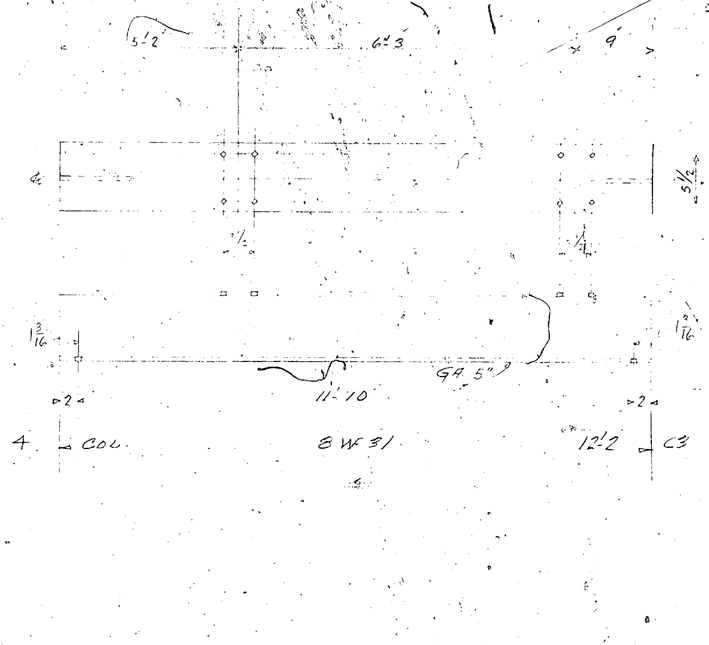

NO. TO SHIP	SHIP MARK	ASSY. MARK	NO. OF PCS.	SECTION	LENGTH FT.	LENGTH IN.	REMARKS	WEIGHT
1	F1		4	8WF24	18	6 3/8		
1	F2							
		a	8	PL 6 x 1	0	6 3/8		
		b	4	L 6 x 4 x 3/8	6	2 3/4		
		c	4	L 2½ x 2½ x ¼	0	2		
			4	¼" SET SCREW	0	2	2 LOCK NUTS TAPERED END	
		d	4	L 5 x 3½ x 3/8	6	2 3/4		
3	F2		6	8WF24	19	2		
		a	12	PL 6 x 1	0	6 3/8		
		b	6	L 6 x 4 x 3/8	6	2 3/4		
		c	6	L 2½ x 2½ x ¼	0	2		
			6	¼" SET SCREW	0	2	DO.	
		d	6	L 5 x 3½ x 3/8	6	2 3/4		
1	C1		2	8WF17	12	2		
1	C2							
4	C3		4	8WF31	12	2		
4	P1		4	PL 4 x 1	0	5 1/4		
8	P2		8	PL 4 x 1	0	8		
FIELD BOLTS								
40			40	¾" M.B.	0	2½	w. LOCK WASHER	
ANCHOR BOLTS								
16			16	1" ø M.E.			w. LOCK WASHER	
16			16	1" CAST ANCHOR			2 UNIT	
8			8	¾" M.B.			w. LOCK WASHER	
8			8	¾" CAST ANCHOR			2 UNIT	

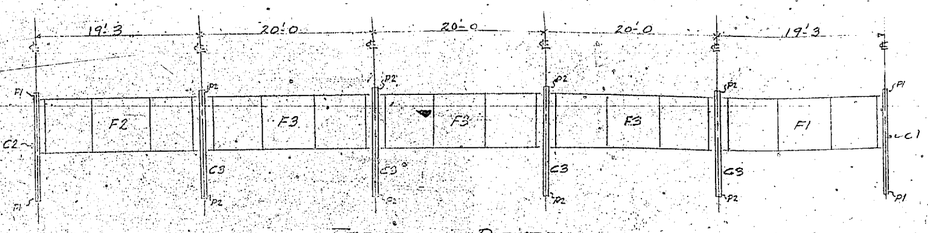

ERECTION DIAGRAM
SET TRAVEL LOCKS TO SUIT COLLISION

RIVETS ____ HOLES 13/16 ø UNLESS NOTED
EDGE DISTANCE NOTED
PAINT STATE A-2
FIELD CONNS. ____
INSPECTION BY ____

STANDARD STEEL FABRICATING CO., INC.
1040 W. HANFORD STREET, SEATTLE

SNOW FENCE FRAME
LAKE KEECHELUS SNOWSHEDS
WASHINGTON STATE HIGHWAY DEPARTMENT.

DRAWN ZLK 8/20/51	APPROVED	DWG. NO.	1
TRACED	DATE	JOB NO.	5372
CHECKED	SCALE		

FED. ROAD DIST. NO.	STATE	FED. AID PROJ. NO.	FISCAL YEAR	SHEET NO.	TOTAL SHEETS
8	WASH.				

Designing Engineer	
Designed	
Design Checked	
Drawn by	
Quantities Figured	
Quantities Checked	

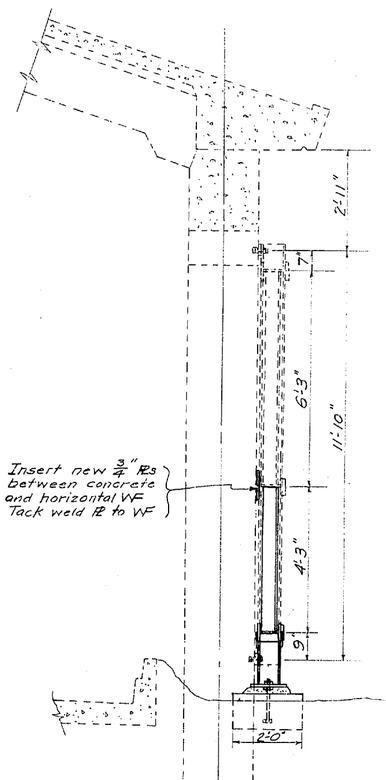

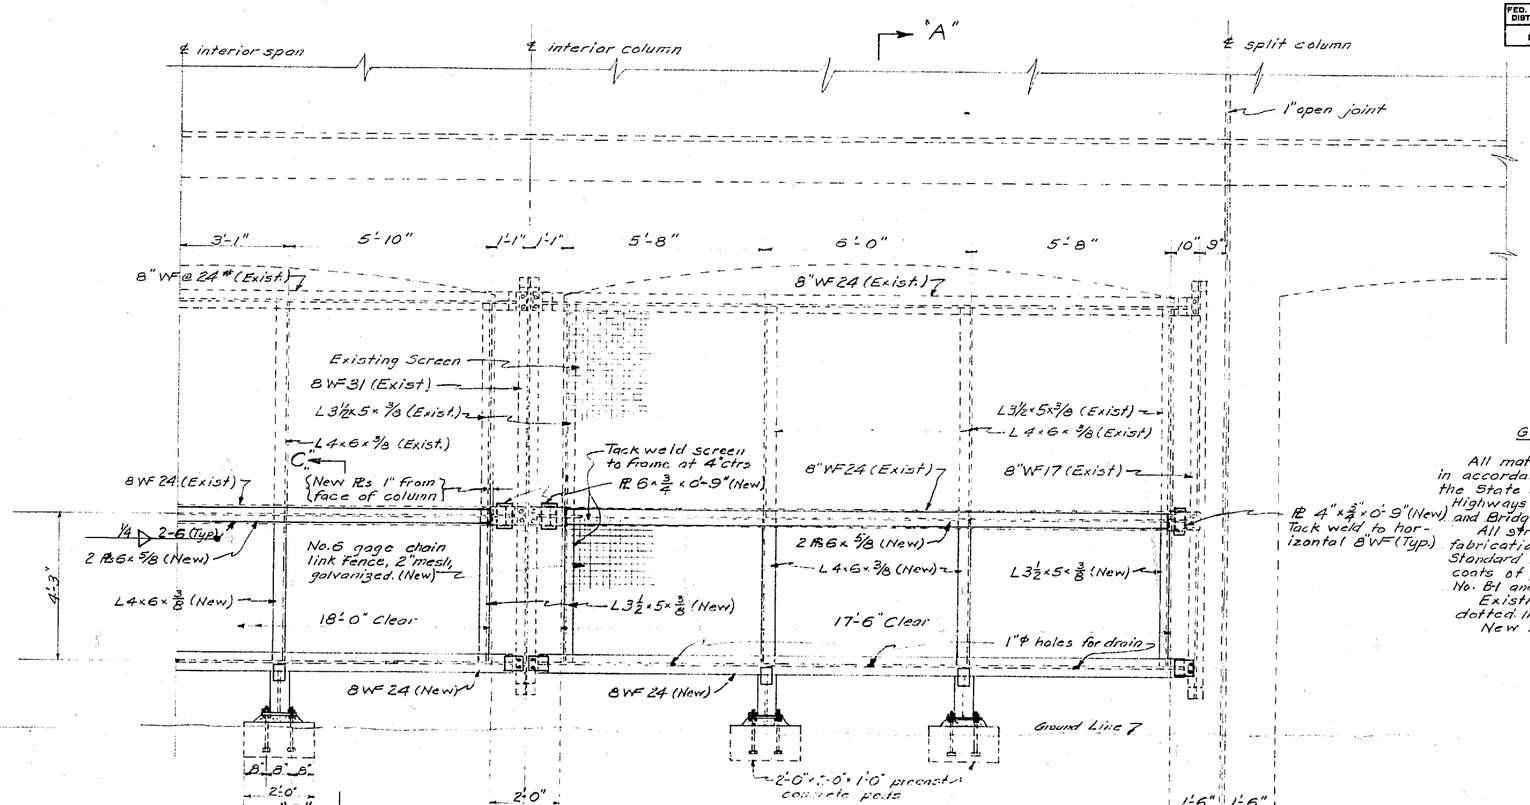

GENERAL NOTES

All material and workmanship shall be in accordance with the requirements of the State of Washington, Department of Highways Standard Specifications for Road and Bridge Construction, Dated April, 1948.

All structural steel shall be paint, after fabrication, one shop coat of Paint, State Standard Formula No. A-1, and two field coats of paint, State Standard Formulas No. B-1 and C-2

Existing structure and fence shown dotted lines.

New material shown solid lines.

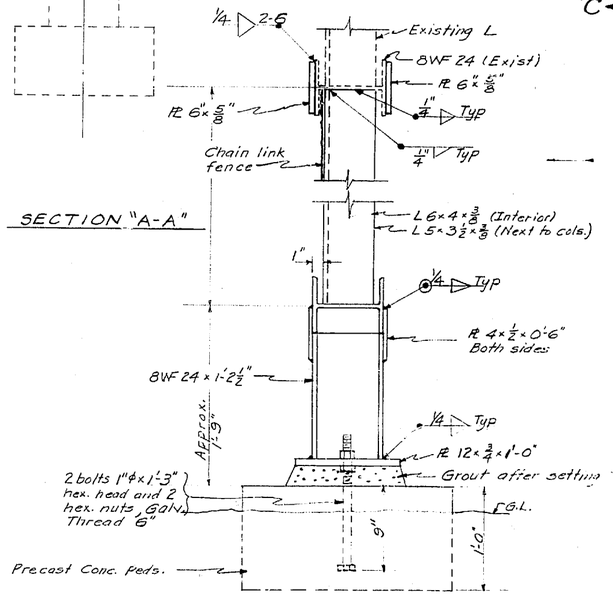

SECTION "A-A"

SECTION "C-C"

5 spans @ 20'-0" each 100 foot unit between split columns

One Only 100 foot unit to be constructed this project

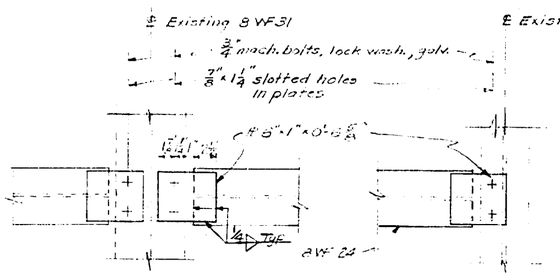

FRAME END CONNECTION DETAILS

ALTERNATE VERTICAL SUPPORTS

This support may be substituted for that shown in Elev. View and Section "C-C" if local source of concrete is available. First place fence frames and 8 WF 24 support. Then cast concrete pads around WF in place.

PRIMARY STATE HIGHWAY NO. 2
LAKE KEECHELUS SNOWSHED
KITTITAS COUNTY

SNOW FENCE — ADDITION

STATE OF WASHINGTON
DEPARTMENT OF HIGHWAYS
OLYMPIA, WASHINGTON

APPROVED:

Leroy Stevens
BRIDGE ENGINEER

JUNE 30, 1955
DATE

72/195-B

DIETZGEN-POST CO. PRINTED ON CLEARPRINT NO. 1000H

Note: Profile grade shown is Finished Grade

FED. ROAD DIST. NO.	STATE	FED. AID PROJ. NO.	FISCAL YEAR	SHEET NO.	TOTAL SHEETS
8	WASH.				

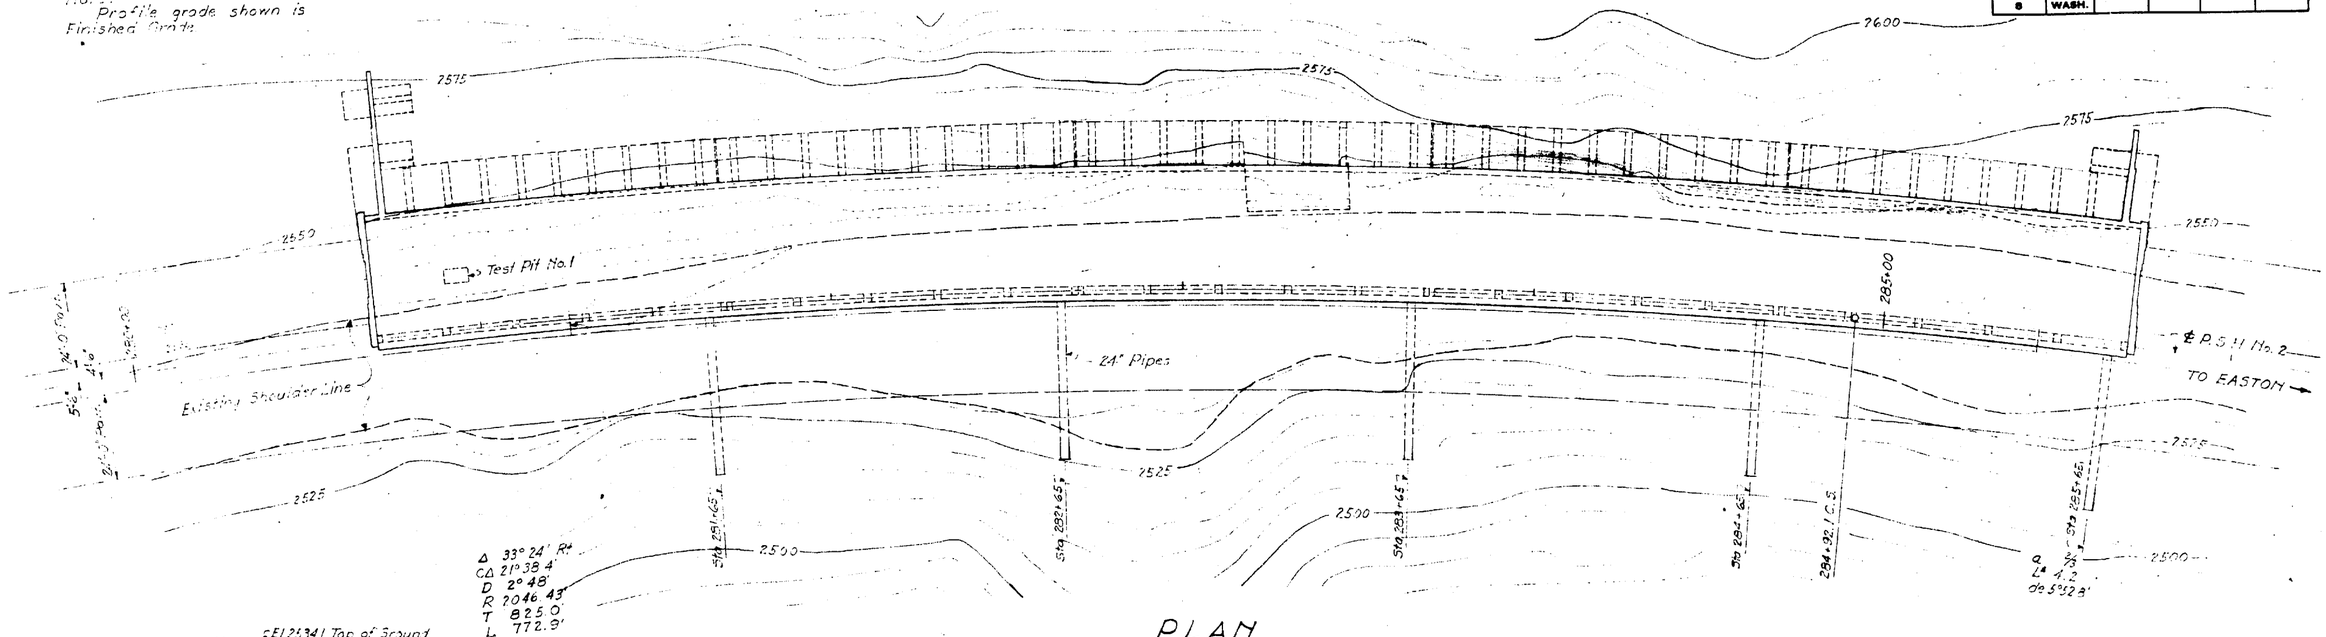

PLAN

Scale: 1"=20'0"

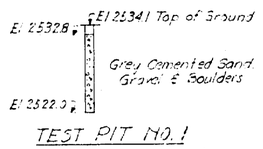

TEST PIT NO. 1

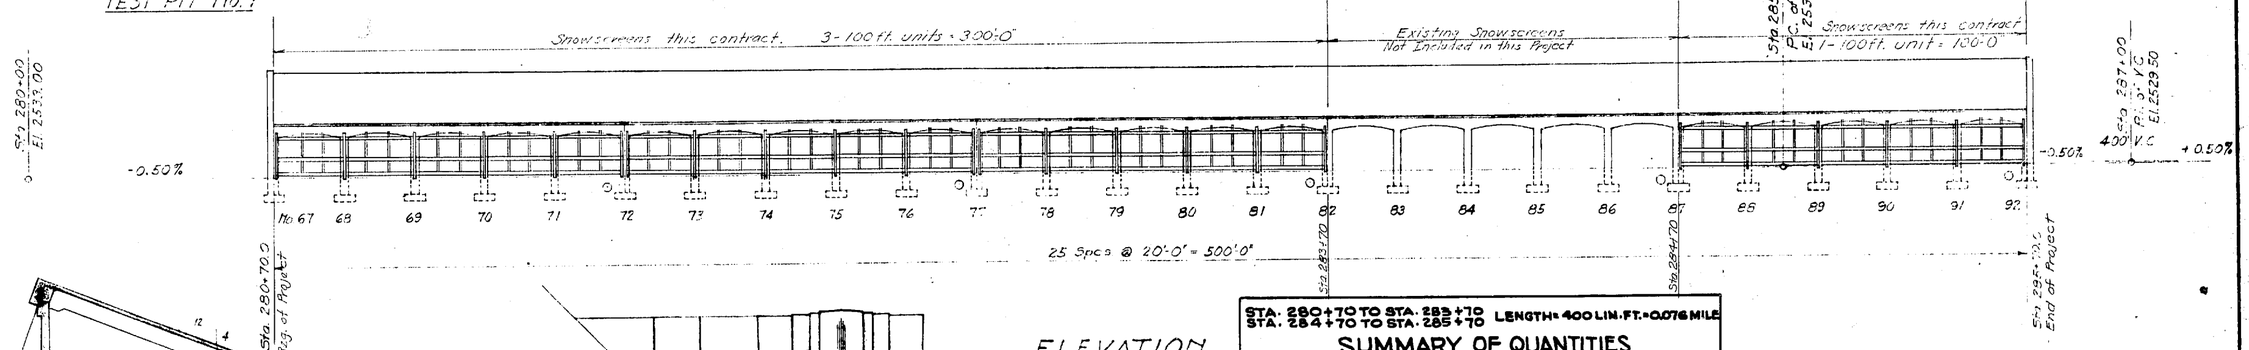

ELEVATION

(Developed along centerline)

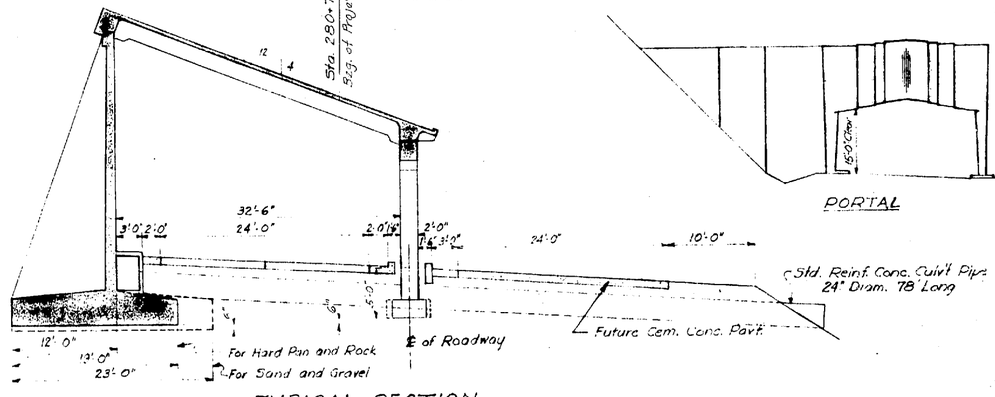

TYPICAL SECTION

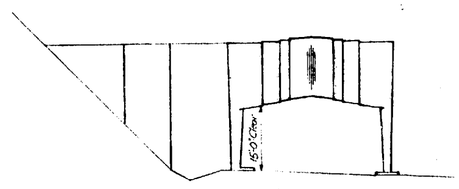

PORTAL

STA. 280+70 TO STA. 283+70
STA. 284+70 TO STA. 285+70 LENGTH = 400 LIN. FT. = 0.076 MILE

SUMMARY OF QUANTITIES

ITEM NO.	QUANTITY	UNIT	ITEM
1	66,000	POUNDS	STRUCTURAL CARBON STEEL
2	4,000	SQ. FT.	CHAIN LINK FENCE
3	96	ONLY	EXPANSION BOLTS
4	6	CU. YDS.	CONCRETE CLASS B

NOTE: For Special Features See Special Provisions.

PRIMARY STATE HIGHWAY NO. 2
LAKE KEECHELUS SNOWSHED SNOW FENCE
KITTITAS COUNTY

LAYOUT

WASHINGTON STATE HIGHWAY COMMISSION
DEPARTMENT OF HIGHWAYS
OLYMPIA, WASHINGTON

E. C. HUNTLEY, Chairman
H. E. HENSEL, Member — OSCAR E. STONE, Member
H. E. MORGAN, Member — R. A. MUNRO, Member

APPROVED May 4, 1956 — APPROVED May 4, 1956

DIRECTOR OF HIGHWAYS — STATE ENGINEER

CONTRACT NUMBER 5280

SHEET 1 OF 2 SHEETS

5830

Designing Engineer	Carlson
Designed	Sept. 1955
Drawn By	C. P. N.
Checked	Sept. 1955
Estimates Prepared	B. V.
Quantities Checked	

FED. ROAD DIST. NO.	STATE	FED. AID PROJ. NO.	FISCAL YEAR	SHEET NO.	TOTAL SHEETS
8	WASH.				

Designing Engineer	C.C.H.	4-56
Designed	C.H.A.	4-56
Design Checked	C.C.H.	4-56
Drawn by		
Quantities Figured		
Quantities Checked		

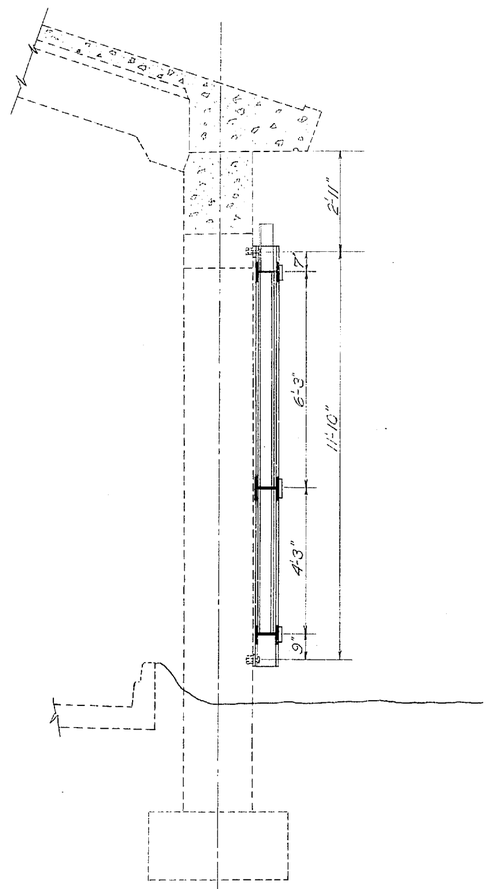

SECTION A-A

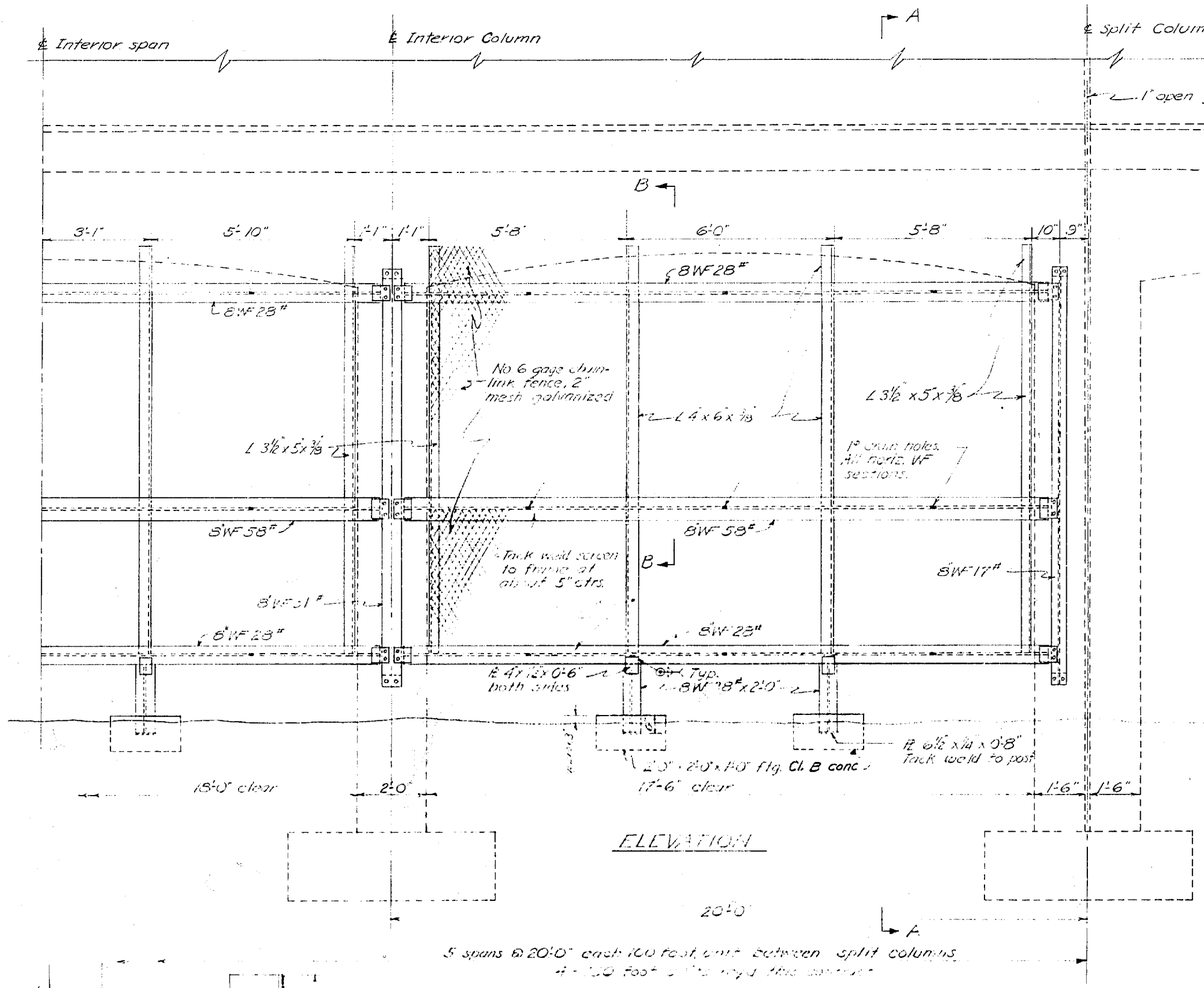

ELEVATION

20'-0"

5 spans @ 20'-0" each = 100 feet, c. to c. between split columns

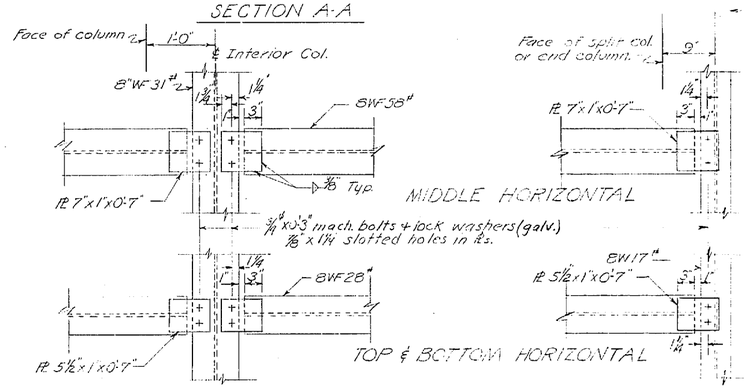

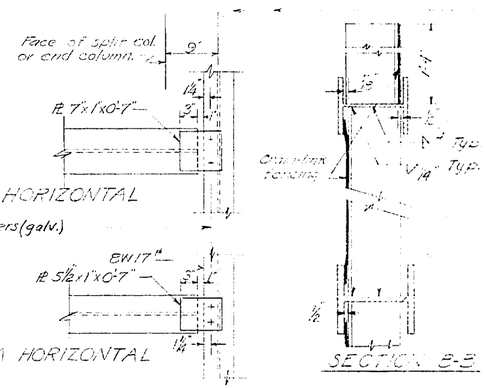

FRAME END CONNECTION DETAILS

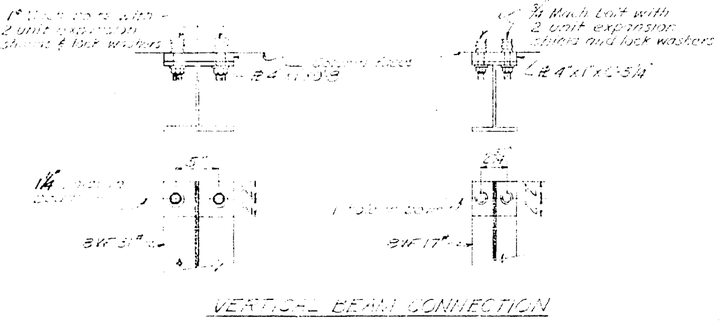

VERTICAL BEAM CONNECTION

BOTTOM CONNECTION SIMILAR

GENERAL NOTES

All material and workmanship shall be in accordance with the requirements of the State of Washington, Department of Highways Standard Specifications for Road and Bridge Construction, Dated April, 1948.

All structural steel shall be painted, after fabrication, one shop coat of paint, State Standard Formula No. A-1, and two field coats of paint, State Standard Formula No. B-1 and C-2.

PRIMARY STATE HIGHWAY NO. 2
LAKE KEECHELUS SNOWSHED SNOW FENCE
KITTITAS COUNTY

DETAILS

WASHINGTON STATE HIGHWAY COMMISSION
DEPARTMENT OF HIGHWAYS
OLYMPIA, WASHINGTON

E. C. HUNTLEY, Chairman
E. E. HENSEL, Member — OSCAR E. STONE, Member
E. E. MORGAN, Member — R. A. MOSIO, Member

APPROVED: May 4, 1956
W. A. Bugge
DIRECTOR OF HIGHWAYS

APPROVED: May 4, 1956
Serge Lumm
BRIDGE ENGINEER

CONTRACT NUMBER 5280

SHEET 2 OF 2 SHEETS

72/195-D

S
830

FED. ROAD DIV. NO.	STATE	FED. AID PROJ. NO.	FISCAL YEAR	SHEET NO.	TOTAL SHEETS
8	WASH.				

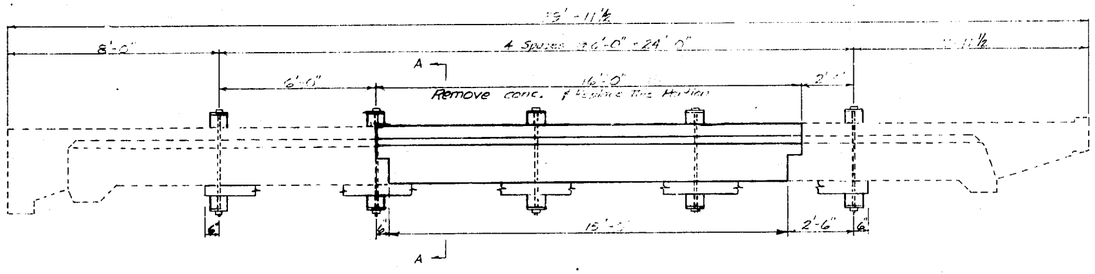

ELEVATION

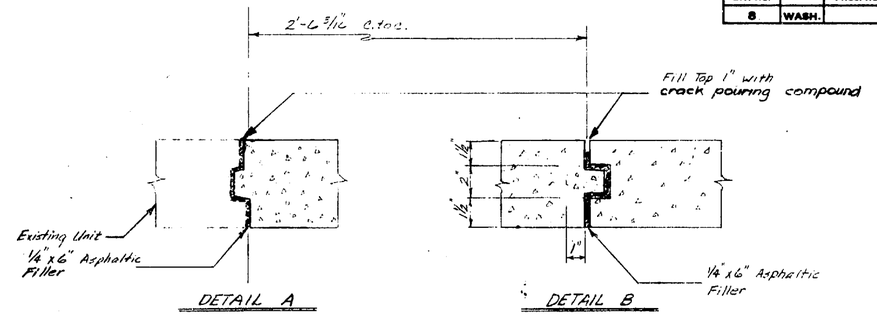

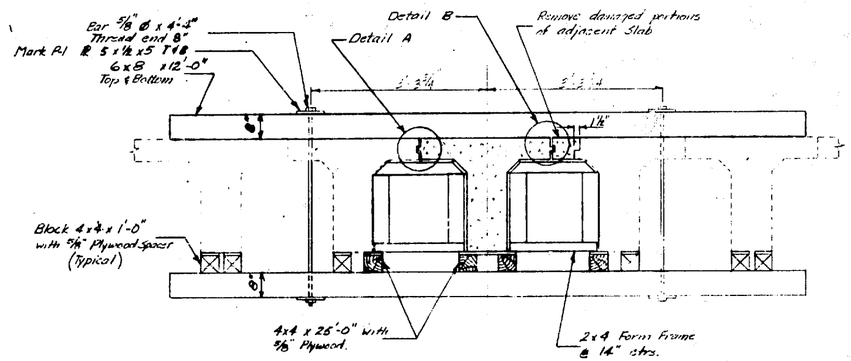

SECTION A-A

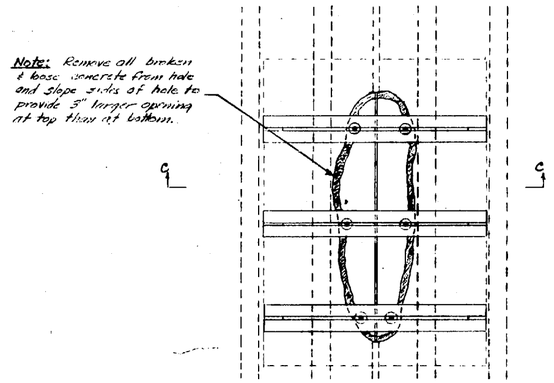

TYPICAL DECK HOLE

GENERAL NOTES

All material and work shall be in accordance with the State of Washington, Department of Highways Standard Specifications for Road and Bridge Construction dated July 1957.

All broken, cracked & loose concrete shall be removed from damaged areas. Existing reinforcing steel shall be thoroughly cleaned before placing concrete. Existing conc. shall be clean and good bond between new and old conc. shall be provided.

All conc. shall be class "A"

Roof shall be water proofed in damaged area by placing 2 layers of fabric & 3 moppings of asphalt.

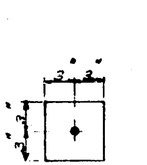

Mark P.1
PL 5 x ¼ x 6"
20 Required

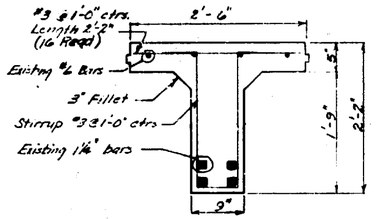

BEAM SECTION

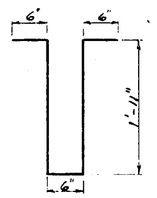

Stirrup #3 bar
16 Required

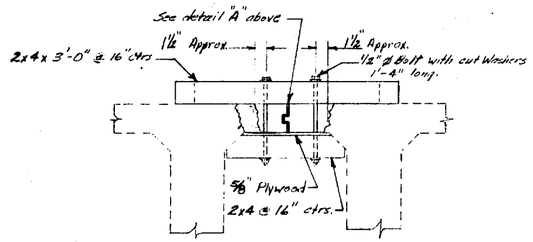

SECTION C-C

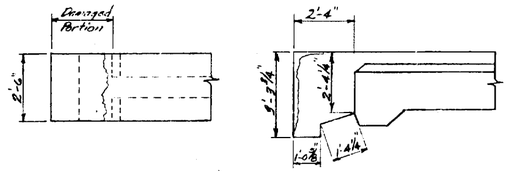

END SECTION PRECAST BEAM

Note:
Waterproof joints of Beam units with 2 layers of fabric 3 moppings of asphalt to match existing structure.

PRIMARY STATE HIGHWAY NO. 2
AIRPLANE CURVE & L.K. KEECHELUS SNOWSHEDS
KING & KITTITAS COUNTIES

BEAM & SLAB REPAIR

APPROVED July 30 1962

BRIDGE ENGINEER

SHEET 1 OF 1 SHEETS

72/193-A

FED. ROAD DIV. NO.	STATE	FED. AID PROJ. NO.		SHEET NO.	TOTAL SHEETS

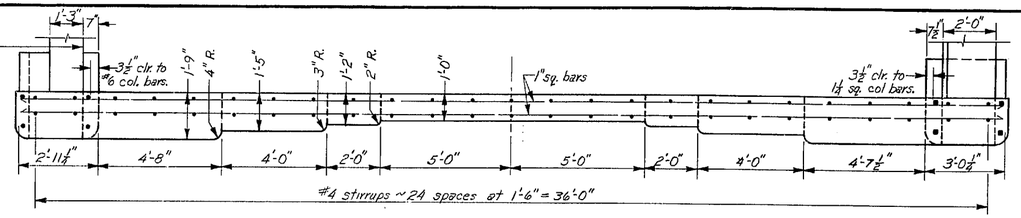

SECTION A-A
Roof beams not shown.

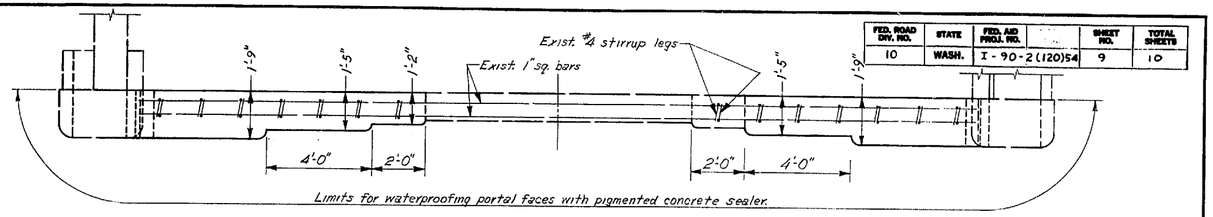

SECTION D-D
Roof beams not shown

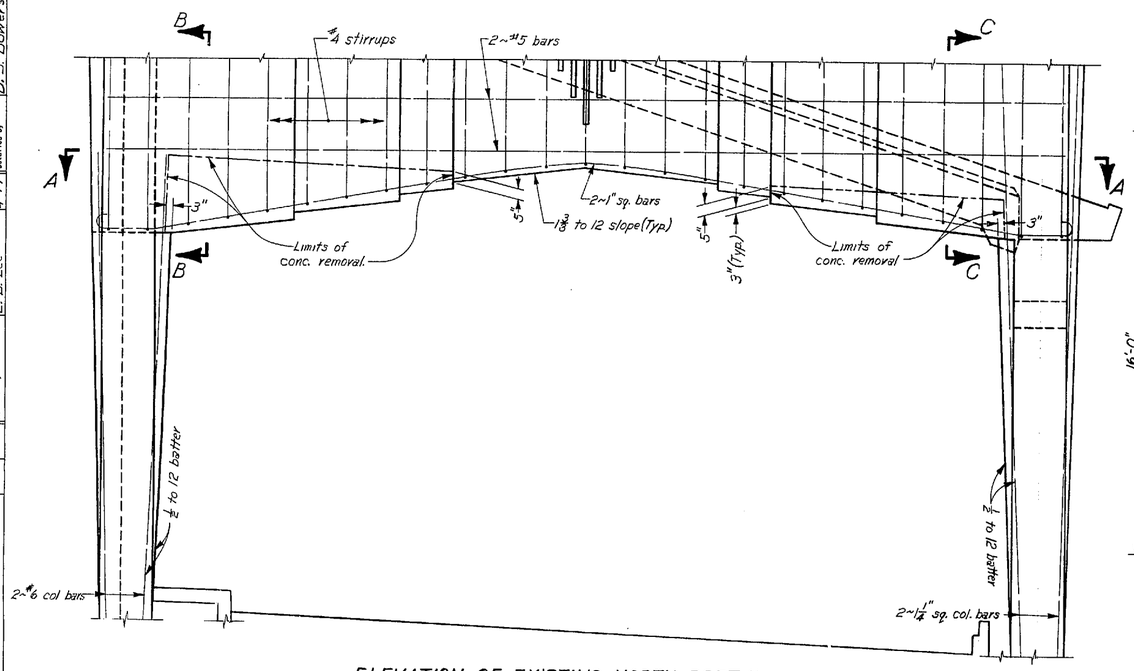

ELEVATION OF EXISTING NORTH PORTAL
LAKE KEECHELUS
South Portal similar.

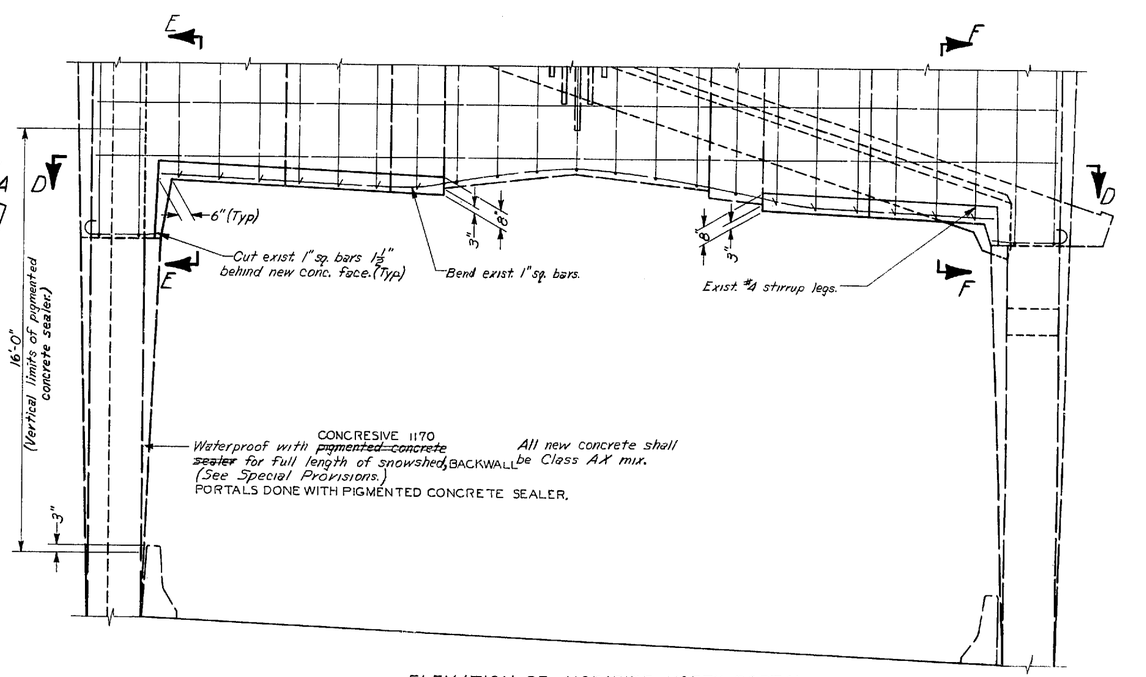

ELEVATION OF MODIFIED NORTH PORTAL
LAKE KEECHELUS
South Portal similar

Note:
See next sheet for General Notes and Approximate Quantities related to the work shown on this sheet and the following sheet.

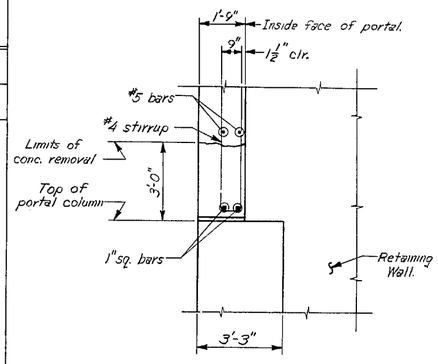

SECTION B-B

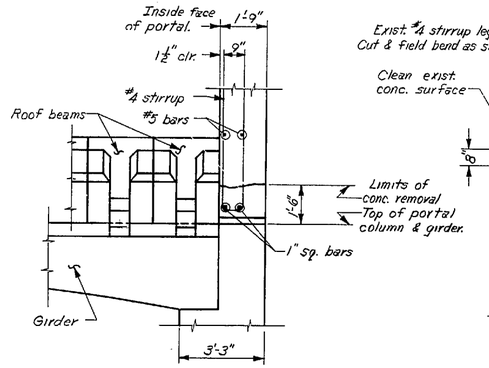

SECTION C-C

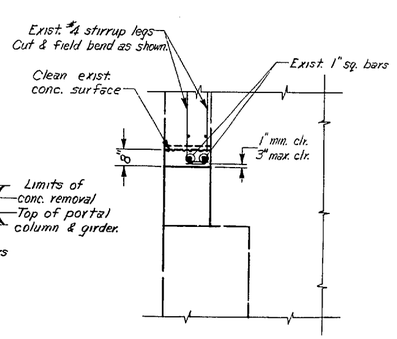

SECTION E-E

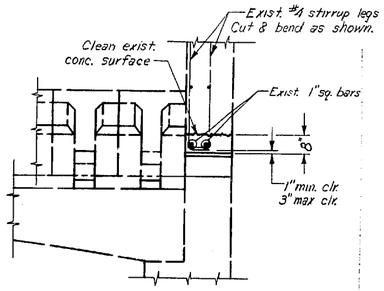

SECTION F-F

SR 90 **MP 57.99 TO MP 61.45**

LAKE KEECHELUS SNOWSHED VIC.
SAFETY IMPROVEMENTS
KITTITAS COUNTY

SNOWSHED MODIFICATION PLAN

WASHINGTON STATE HIGHWAY COMMISSION
DEPARTMENT OF HIGHWAYS
OLYMPIA, WASHINGTON

W. A. BULLEY — DIRECTOR OF HIGHWAYS

C. S. Lloyd — BRIDGE ENGINEER — APPROVED June 3, 1977

CONTRACT NUMBER 0791 — SHEET 11 OF 12 SHEETS

AS BUILT CHANGES IN RED 1-11-79

APP'D	Engineer of Bridge Design		
	Supervising Bridge Engr.	Jerry Nowicki / K.F. Lee	10-77 / 11-77
	Reviewed By	E. D. Lee	4-77
BY	Designed By	D. S. Bowers	4-77
	Design Checked By	M. R. Wallace	4-77
	Detailed By	D. S. Bowers	4-77
	Layout By		
	Layout Checked By		
	Traced By		

APP'D	DATE	REVISION
RB		
	7-1-77	Rev. MP & Sheet No.

SR 90 JOB NO. SHEET

115/130

7

SR 90/

FED. ROAD DIV. NO.	STATE	FED. AID PROJ. NO.		SHEET NO.	TOTAL SHEETS
10	WASH.	I-90-2(120)54		10	10

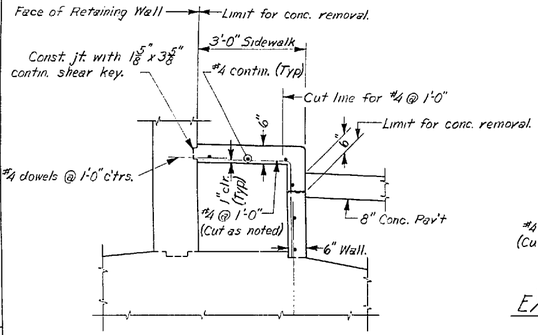

TYPICAL SECTION~EXISTING SIDEWALK

As sidewalk is removed, shoring will be req'd to prevent 6" wall from collapsing.

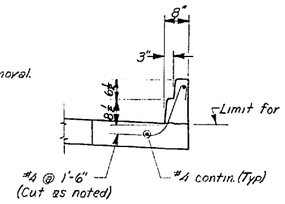

TYPICAL SECTION
EXISTING CURB & GUTTER

BAR LIST

A.S.T.M. A-615 Grade 60. Dimensions are out to out.

Mark No.	Location	Size	No. Req'd	Bend Type	Length per Bar	Total Weight
1	Longitudinal Slab	4	54	Straight	30'-0"	1082.
2	Transverse Slab	6	500	2¼" Rad. 3'-7" 4½"	4'-2"	3130.

GENERAL NOTES

All material and work shall be in accordance with the requirements of the State of Washington, Department of Highways, Standard Specifications for Road and Bridge Construction dated 1977.

APPROXIMATE QUANTITIES

Steel Reinforcing Bar for Structure	4200 Lbs.
Concrete Class AX for Structure	32 C.Y.
Removing Portions of Existing Structure	L.S. Lump Sum
Waterproofing with Pigmented Concrete Sealer	970 S.Y.

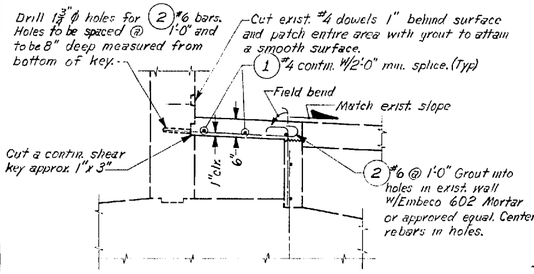

MODIFIED SECTION~SIDEWALK SIDE

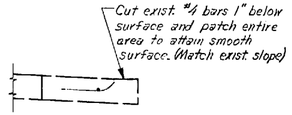

MODIFIED SECTION
CURB & GUTTER SIDE

All new concrete shall be Class AX mix.

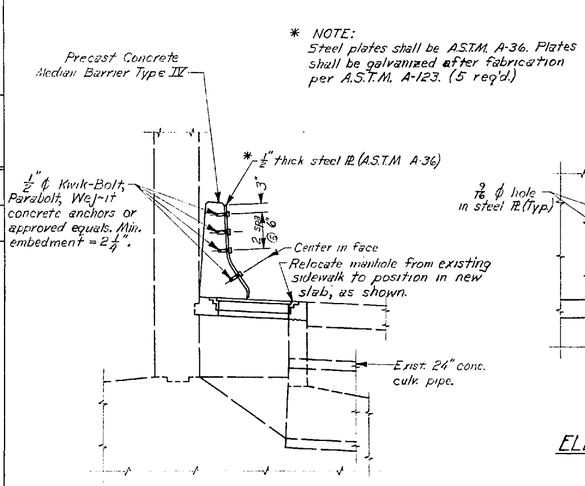

SECTION THRU MANHOLE COVER

Detail typical at 5 locations.

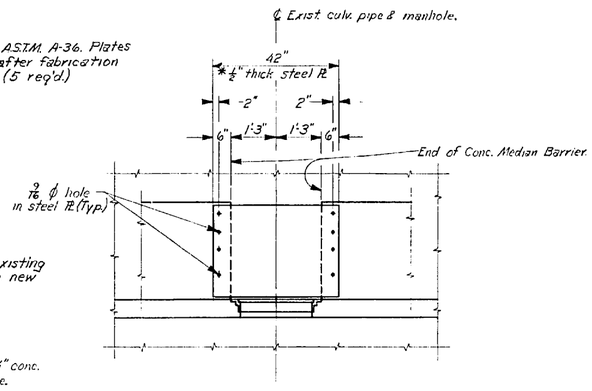

ELEVATION VIEW AT MANHOLE COVER

SR 90 **MP 57.99 TO MP 61.45**

LAKE KEECHELUS SNOWSHED VIC.

SAFETY IMPROVEMENTS

KITTITAS COUNTY

SNOWSHED MODIFICATION PLAN

WASHINGTON STATE HIGHWAY COMMISSION
DEPARTMENT OF HIGHWAYS
OLYMPIA, WASHINGTON

W. A. BULLEY DIRECTOR OF HIGHWAYS

C. S. Lloyd BRIDGE ENGINEER

APPROVED June 3, 1977

CONTRACT NUMBER 0791

SHEET 12 OF 12 SHEETS

BY	APP'D	DATE	REVISION
R.B.		7-1-77	Rev. MP & Sheet No.

Layout By: 4-77 D.S. Bowers
Layout Checked By: 4-77 M. R. Wallace
Traced By: 4-77 D.S. Bowers
Designed By: 5-77 E. D. Lee
Design Checked By: 4-77 W. J. Adamowski
Detailed By: 4-77 E. D. Lee
Engineer of Bridge Design:
Supervising Bridge Engr.:
Reviewed By:

SR 90 JOB NO. SHEET

115/129

SR 90/1417

FED. ROAD DIV. NO.	STATE	FED. AID PROJ. NO.	FISCAL YEAR	SHEET NO.	TOTAL SHEETS
10	WASH.	S-30-2(11)214		5	6

78W063

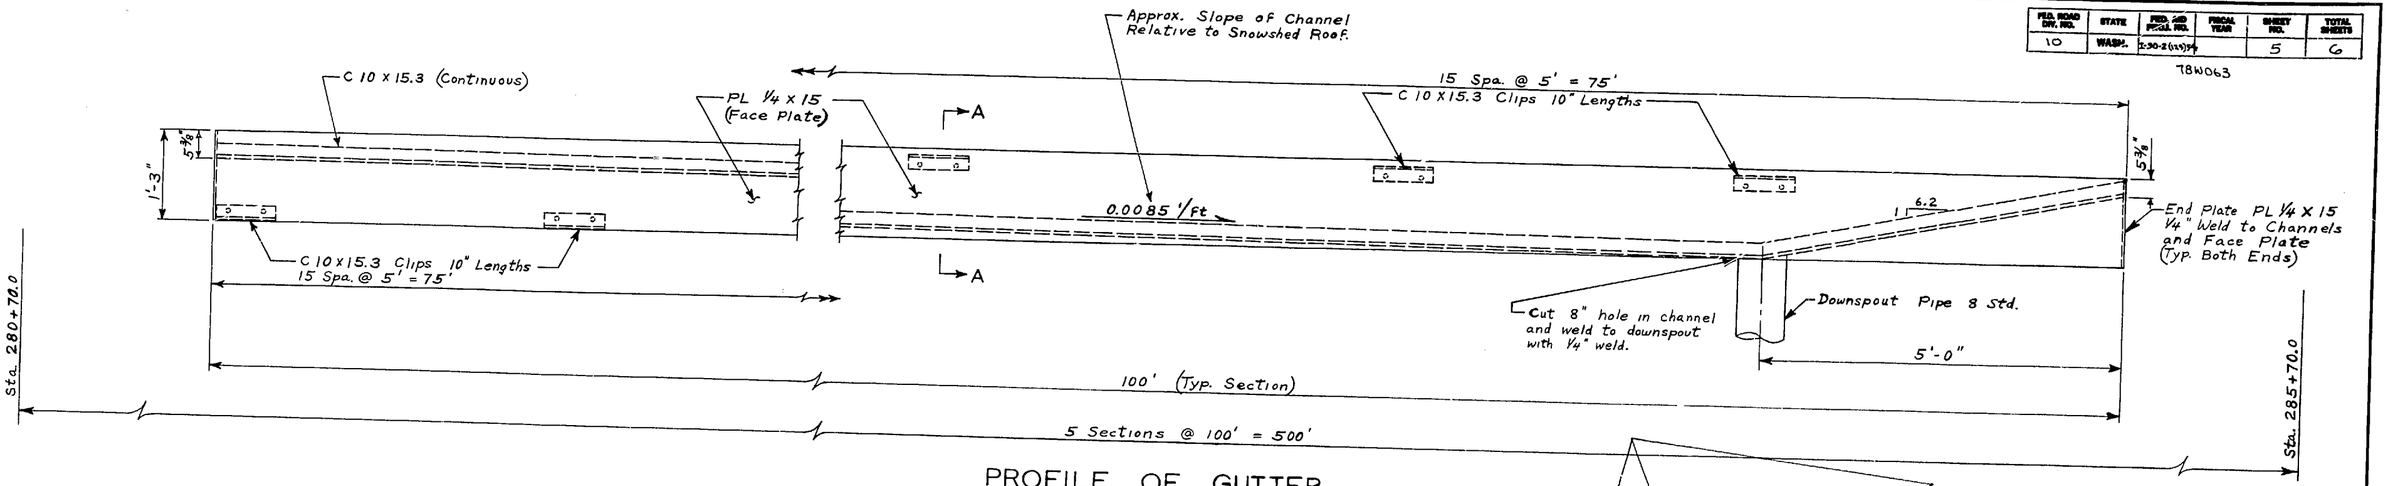

PROFILE OF GUTTER

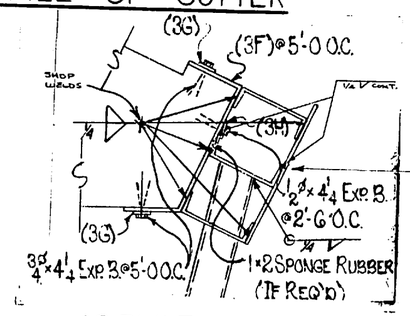

AS BUILT CHANGE

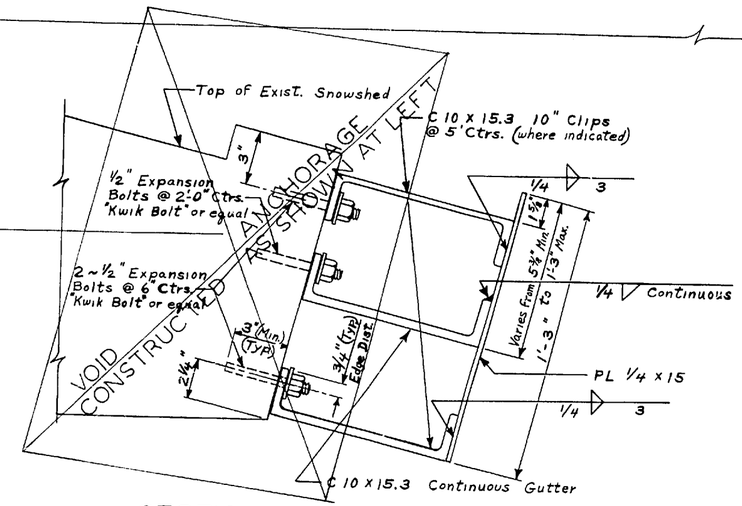

SECTION VIEW OF GUTTER
SECTION A-A

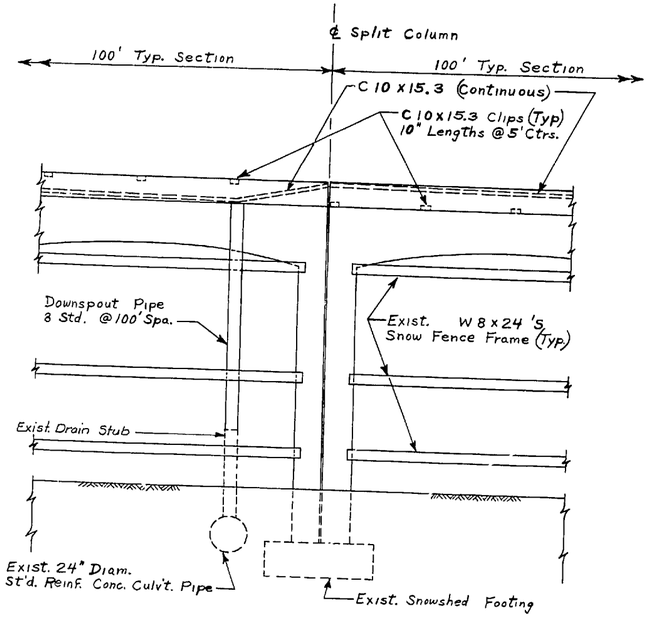

PROFILE VIEW OF DOWNSPOUT

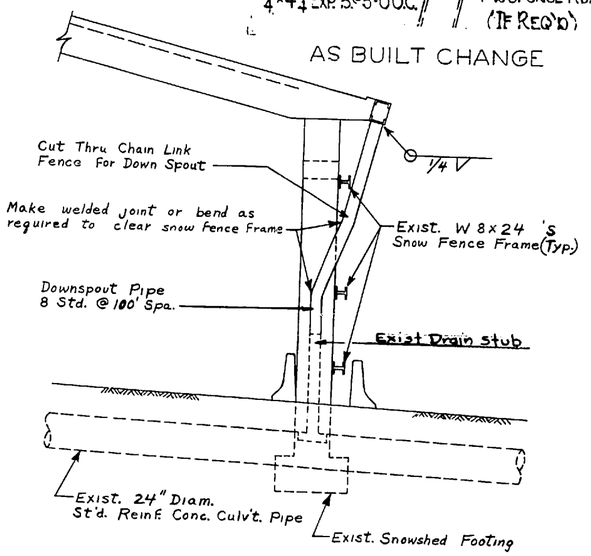

SECTION VIEW OF DOWNSPOUT

See Detail A sheet 4

GENERAL NOTES

All material and work shall be in accordance with the requirements of the State of Washington, Department of Highways, Standard Specifications for Road and Bridge Construction, dated 1977.

Determine by Field measurement prior to fabrication, the location and dimensions of pertinant features of the existing Facility.

All intermediate joints of the plates, channels, and down spouts shall be connected by full penetration butt welds.

SR 90 MP 57.88 TO MP 58.17
LAKE KEECHELUS SNOWSHED VIC.
ROCKFALL ABATEMENT
KITITAS COUNTY

LAKE KEECHELUS SNOWSHED ROOF DRAINAGE

WASHINGTON STATE DEPARTMENT OF TRANSPORTATION
OLYMPIA, WASHINGTON

W. A. BIGGS — SECRETARY

C. S. Lloyd

1093 — APPROVED March 24, 1978 — SHEET 5 OF 6 SHEETS

AS BUILT CHANGE 4-11-80

APP'D	DATE	REVISION	BY	APP'D	DATE
	5-12-78	New Sheet		P.B.	

	Engineer of Bridge Design	R. H. Reed	9-77
	Supervising Bridge Engr.	J.L. McIntosh	8-77
	Reviewed By		
APP'D	Designed By	M.J. Witecki	8-77
	Design Checked By	J.L. McIntosh	8-77
	Detailed By	M.J. Witecki	8-77
	Layout By		
	Layout Checked By		
	Traced By		

SR 90 JOB NO. SHEET

SR 90
/431